

1 LOCATION OF WATER WELL: Fracture	Section Number	Township Number	Range Number
County: <u>Seelye NE 1/4 NW 1/4 SE 1/4</u>	<u>16</u>	T <u>26</u> S <u>0</u>	R <u>2</u> E <u>10</u>

Distance and direction from nearest town or city street address of well if located within city?

512 Union Crt. Colwich, KS2 WATER WELL OWNER: Martin Shriner

RR#, St. Address, Box #

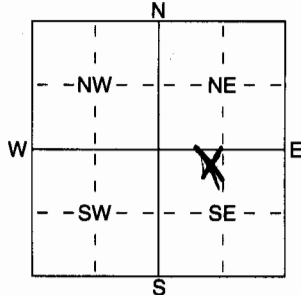
City, State, ZIP Code

512 Union Crt. Colwich, KS 67036

Board of Agriculture, Division of Water Resources

Application Number:

3 LOCATE WELL'S LOCATION WITH AN "X" IN SECTION BOX:

4 DEPTH OF COMPLETED WELL 05 ft. ELEVATION:

Depth(s) Groundwater Encountered ft. 2 ft. 3 ft.

WELL'S STATIC WATER LEVEL 15 ft. below land surface measured on mo/day/yr

Pump test data: Well water was ft. after hours pumping gpm

Est. Yield 25 gpm: Well water was ft. after hours pumping gpm

WELL WATER TO BE USED AS: 5 Public water supply 8 Air conditioning 11 Injection well

1 Domestic 3 Feedlot 6 Oil field water supply 9 Dewatering 12 Other (Specify below)

2 Irrigation 4 Industrial 7 Domestic (lawn & garden) 10 Monitoring wellWas a chemical/bacteriological sample submitted to Department? Yes No X; If yes, mo/day/yr sample was submitted Water Well Disinfected? Yes 0 No

5 TYPE OF BLANK CASING USED:

- 1 Steel
2 PVC
3 RMP (SR)
4 ABS

- 5 Wrought iron
6 Asbestos-Cement
7 Fiberglass

- 8 Concrete tile
9 Other (specify below)

CASING JOINTS: Glued X Clamped
Welded
ThreadedBlank casing diameter in. to 55 ft. Dia in. to ft. Dia in. to ft.Casing height above land surface 10 in., weight 24 lbs./ft. Wall thickness or gauge No. 160 PSI

TYPE OF SCREEN OR PERFORATION MATERIAL:

- 1 Steel
2 Brass
3 Stainless Steel
4 Galvanized Steel

- 5 Fiberglass
6 Concrete tile

- 7 PVC
8 RMP (SR)
9 ABS

- 10 Asbestos-Cement
11 Other (Specify)
12 None used (open hole)

SCREEN OR PERFORATION OPENINGS ARE:

- 1 Continuous slot
2 Louvered shutter
3 Mill slot
4 Key punched

- 5 Gauzed wrapped
6 Wire wrapped
7 Torch cut

- 8 Saw cut
9 Drilled holes
10 Other (specify) ft.
11 None (open hole)

SCREEN-PERFORATED INTERVALS: From ft. to ft., From ft. to ft.

GRAVEL PACK INTERVALS: From 15 ft. to 05 ft., From ft. to ft.

6 GROUT MATERIAL:

1 Neat cement 2 Cement grout 3 Bentonite 4 OtherGrout intervals: From 3 ft. to 15 ft., From ft. to ft., From ft. to ft.

What is the nearest source of possible contamination:

- 1 Septic tank
2 Sewer lines
3 Watertight sewer lines
4 Lateral lines
5 Cess pool
6 Seepage pit

- 7 Pit privy
8 Sewage lagoon
9 Feedyard

- 10 Livestock pens
11 Fuel storage
12 Fertilizer storage
13 Insecticide storage
14 Abandoned water well
15 Oil well/Gas well
16 Other (specify below)

Direction from well? westHow many feet? 20

FROM	TO	LITHOLOGIC LOG	FROM	TO	PLUGGING INTERVALS
0	1	topsoil			
1	25	clay			
25	30	fine sand			
30	40	med sand			
40	50	fine sand			
50	65	med sand			

7 CONTRACTOR'S OR LANDOWNER'S CERTIFICATION: This water well was (1) constructed, (2) reconstructed, or (3) plugged under my jurisdiction and was completed on (mo/day/year) and this record is true to the best of my knowledge and belief. Kansas

Water Well Contractor's Licence No #040

This Water Well Record was completed on (mo/day/yr)

under the business name of Winger Drilling Inc.by signature Ashley Winger