

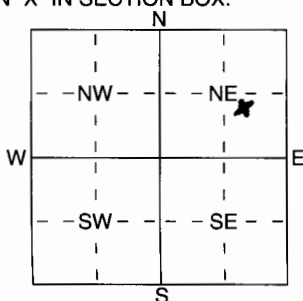
1 LOCATION OF WATER WELL:	Fraction	Section Number	Township Number	Range Number
County: <u>Sedgwick</u>	<u>NW 1/4 SE 1/4 NE 1/4</u>	<u>21</u>	T <u>26</u> S	R <u>2</u> EW

Distance and direction from nearest town or city street address of well if located within city?

413 Homestead Ct. Colwich, KS

2 WATER WELL OWNER:	Board of Agriculture, Division of Water Resources
RR#, St. Address, Box # : <u>John Scott</u>	Application Number:
City, State, ZIP Code : <u>413 Homestead Ct.</u>	
<u>Colwich, KS 67030</u>	

3 LOCATE WELL'S LOCATION WITH AN "X" IN SECTION BOX:	4 DEPTH OF COMPLETED WELL <u>80</u> ft. ELEVATION:
--	--

Depth(s) Groundwater Encountered 1 22 ft. 2 ft. 3 ft.WELL'S STATIC WATER LEVEL 22 ft. below land surface measured on mo/day/yr 2-9-06

Pump test data: Well water was ft. after hours pumping gpm

Est. Yield 40 gpm: Well water was ft. after hours pumping gpm

WELL WATER TO BE USED AS: 5 Public water supply 8 Air conditioning 11 Injection well

1 Domestic 3 Feedlot 6 Oil field water supply 9 Dewatering 12 Other (Specify below)

2 Irrigation 4 Industrial 10 Domestic (lawn & garden) 10 Monitoring wellWas a chemical/bacteriological sample submitted to Department? Yes No X; If yes, mo/day/yr sample was submittedWater Well Disinfected? Yes X No

5 TYPE OF BLANK CASING USED:	5 Wrought iron	8 Concrete tile	CASING JOINTS: Glued <u>X</u> Clamped
------------------------------	----------------	-----------------	---

1 Steel 3 RMP (SR) 6 Asbestos-Cement 9 Other (specify below) Welded

0 PVC 4 ABS 7 Fiberglass ThreadedBlank casing diameter 5 in. to 60 ft., Dia in. to ft., Dia in. to ft.Casing height above land surface 12 in., weight 5 lbs./ft. Wall thickness or gauge No. SPR 26

TYPE OF SCREEN OR PERFORATION MATERIAL:

1 Steel 3 Stainless Steel 5 Fiberglass 0 PVC 10 Asbestos-Cement

2 Brass 4 Galvanized Steel 6 Concrete tile 8 RMP (SR) 11 Other (Specify)

SCREEN OR PERFORATION OPENINGS ARE: 5 Gauzed wrapped 0 Saw cut 11 None (open hole)

1 Continuous slot 3 Mill slot 6 Wire wrapped 9 Drilled holes

2 Louvered shutter 4 Key punched 7 Torch cut 10 Other (specify) ft.

SCREEN-PERFORATED INTERVALS: From 60 ft. to 80 ft., From ft. to ft.

From ft. to ft., From ft. to ft.

GRAVEL PACK INTERVALS: From 20 ft. to 80 ft., From ft. to ft.

From ft. to ft., From ft. to ft.

6 GROUT MATERIAL:	1 Neat cement	2 Cement grout	<u>0</u> Bentonite	4 Other
-------------------	---------------	----------------	--------------------	---------------

Grout Intervals: From 3 ft. to 20 ft., From ft. to ft., From ft. to ft.

What is the nearest source of possible contamination:

1 Septic tank 4 Lateral lines 7 Pit privy 10 Livestock pens 14 Abandoned water well

0 Sewer lines 5 Cess pool 8 Sewage lagoon 11 Fuel storage 15 Oil well/Gas well

3 Watertight sewer lines 6 Seepage pit 9 Feedyard 12 Fertilizer storage 16 Other (specify below)

Direction from well? W to East How many feet? 10'

FROM TO LITHOLOGIC LOG FROM TO PLUGGING INTERVALS

0 3 Topsoil3 45 Tan Clay45 60 Fine Sand - Silty60 80 Coarse Sand to Small Gravel

7 CONTRACTOR'S OR LANDOWNER'S CERTIFICATION: This water well was <u>0</u> constructed, (2) reconstructed, or (3) plugged under my jurisdiction and was completed on (mo/day/year) <u>2-9-06</u> and this record is true to the best of my knowledge and belief. Kansas Water Well Contractor's Licence No <u>238</u> This Water Well Record was completed on (mo/day/yr) <u>2-10-06</u> under the business name of <u>Armer Pump & Well Service Inc.</u> by (signature) <u>W. W. Waring</u>
