

1	LOCATION OF WATER WELL:	Fraction	Section Number	Township Number	Range Number
County:	<i>Sedewick</i>	<i>SW</i> $\frac{1}{4}$ <i>NE</i> $\frac{1}{4}$ <i>NE</i> $\frac{1}{4}$	<i>17</i>	T <i>26</i> S	R <i>2</i> E <i>(W)</i>


Distance and direction from nearest town or city street address of well if located within city?

From Colwick, KS: 1 1/2 miles North + 1 mile West 5959 N. 183rd W.

2] WATER WELL OWNER: *Duang S. S. S. S.*
RR#, St. Address, Box # : *6801 N. 149th St W.*
City, State, ZIP Code : *Colwich, KS 67030*

Board of Agriculture, Division of Water Resources
Application Number:

3 LOCATE WELL'S LOCATION WITH AN "X" IN SECTION BOX: 4 DEPTH OF COMPLETED WELL 60 ft. ELEVATION: _____
Depth(s) Groundwater Encountered 1 20 ft. 2 _____ ft. 3 _____ ft.

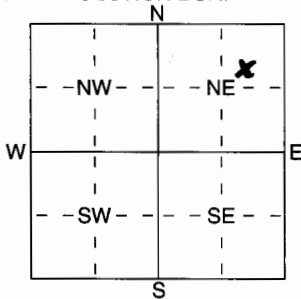

4 DEPTH OF COMPLETED WELL 60 ft. ELEVATION:

Depth(s) Groundwater Encountered 1 20 ft. 2 _____ ft. 3 _____ ft.
WELL'S STATIC WATER LEVEL 20 ft. below land surface measured on mo/day/yr 3-8-06

Pump test data: Well water was ft. after hours pumping gpm
 Est. Yield 40 gpm: Well water was ft. after hours pumping gpm

WELL WATER TO BE USED AS:

1 Domestic	3 Feedlot	5 Public water supply	8 Air conditioning	11 Injection well
2 Irrigation	4 Industrial	6 Oil field water supply	9 Dewatering	12 Other (Specify below)
		7 Domestic (lawn & garden)	10 Monitoring well	

Was a chemical/bacteriological sample submitted to Department? Yes No ✓; If yes, mo/day/yr sample was submitted
Water Well Disinfected? Yes ✓ No

5	TYPE OF BLANK CASING USED:		5 Wrought iron	8 Concrete tile	CASING JOINTS: Glued ☒ Clamped Welded Threaded
	1 Steel	3 RMP (SR)	6 Asbestos-Cement	9 Other (specify below)	
	2 PVC	4 ABS	7 Fiberglass		

Blank casing diameter 5 in. to 40 ft., Dia in. to ft., Dia in. to ft.

Casing height above land surface 12 in., weight 2.5 lbs./ft. Wall thickness or gauge No. SPR 26

TYPE OF SCREEN OR PERFORATION MATERIAL:			☒ PVC	10 Asbestos-Cement
1 Steel	3 Stainless Steel	5 Fiberglass	8 RMP (SR)	11 Other (Specify)
2 Brass	4 Galvanized Steel	6 Concrete tile	9 ABS	12 None used (open hole)

SCREEN OR PERFORATION OPENINGS ARE:

1 Continuous slot	3 Mill slot	5 Guazed wrapped	8 <u>Raw</u> cut	11 None (open hole)
2 Louvered shutter	4 Key punched	6 Wire wrapped	9 Drilled holes	
		7 Torch cut	10 Other (specify)	ft.

SCREEN-PERFORATED INTERVALS: From 40 ft. to 60 ft., From _____ ft. to _____ ft.
From _____ ft. to _____ ft., From _____ ft. to _____ ft.
GRAVEL PACK INTERVALS: From 20 ft. to 60 ft., From _____ ft. to _____ ft.
From _____ ft. to _____ ft., From _____ ft. to _____ ft.

6	GROUT MATERIAL:	1 Neat cement	2 Cement grout	3 Bentonite	4 Other
---	-----------------	---------------	----------------	-------------	---------------

Grout Intervals: From 3 ft. to 20 ft., From _____ ft. to _____ ft., From _____ ft. to _____ ft.

What is the nearest source of possible contamination:

1 Septic tank	4 Lateral lines	7 Pit privy	10 <u>Livestock pens</u>	14 Abandoned water well
2 Sewer lines	5 Cess pool	8 Sewage lagoon	11 Fuel storage	15 Oil well/Gas well
3 Watertight sewer lines	6 Seepage pit	9 Feedyard	12 Fertilizer storage	16 Other (specify below)
			13 Insecticide storage	

Direction from well? West How many feet? 5'

[illegible]

7. CONTRACTOR'S OR LANDOWNER'S CERTIFICATION: This water well was (1) constructed, (2) reconstructed, or (3) plugged under my jurisdiction and was completed on (mo/day/year) 3-8-06 and this record is true to the best of my knowledge and belief. Kansas Water Well Contractor's Licence No. 238 This Water Well Record was completed on (mo/day/yr) 3-8-06 under the business name of Premier Pump & Well Service Inc. by (signature) Chris Womack