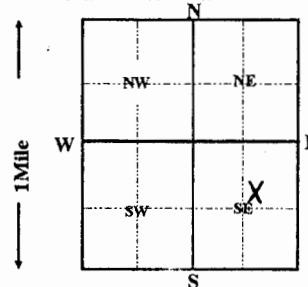


1 LOCATION OF WATER WELL: Sedgwick	FRACTION SW 1/4 NE 1/4 SE 1/4	Section Number 13	Township Number T 26 S	Range Number R 2W E/W
--	---	-----------------------------	----------------------------------	---------------------------------

Distance and direction from nearest town or city street address of well if located within city?
5605 N. 119th West Maize, KS.

2 WATER WELL OWNER: COLEMAN Co. Inc. RR#, ST. ADDRESS, BOX #: 5605 N. 119th West CITY, STATE, ZIP CODE: Maize, Kansas 67101	Board of Agriculture, Division of Water Resource Application Number:
---	---

3 LOCATE WELL'S LOCATION WITH AN "X" IN SECTION BOX: 	4 DEPTH OF COMPLETED WELL 110 ft. ELEVATION: Depth(s) groundwater Encountered 1 ft. 2 ft. 3 ft. WELL'S STATIC WATER LEVEL 15 FT. BELOW LAND SURFACE MEASURED ON 08/04/1992 Pump test data: Well water was ft. after hours pumping gpm Est. Yield gpm: Well water was ft. after hours pumping gpm Bore Hole Diameter in. to ft., and in. to ft. WELL WATER TO BE USED AS: 1 Domestic 3 Feedlot 6 Oil field water supply 9 Dewatering 11 Injection well 2 Irrigation 4 Industrial 7 Lawn and garden only 10 Monitoring well 12 Other (Specify below) Was a chemical/bacteriological sample submitted to Department? Yes No ; If yes, mo/day/yr sample was submitted Water Well Disinfected? Yes X No
--	--

5 TYPE OF CASING USED: 1 Steel 3 RMP (SR) 2 PVC 4 ABS Blank casing Diameter 6 in. to 3 ft., Dia in. to ft. Casing height above land surface in., weight lbs. / ft. TYPE OF SCREEN OR PERFORATION MATERIAL: 1 Steel 3 Stainless Steel 5 Fiberglass 8 RMP (SR) 2 Brass 4 Galvanized steel 6 Concrete tile 9 ABS SCREEN OR PERFORATION OPENING ARE: 1 Continuous slot 3 Mill slot 5 Gauzed wrapped 8 Saw cut 11 None (open hole) 2 Louvered shutter 4 Key punched 6 Wire wrapped 9 Drilled holes 12 None used (open hole) 7 Torch cut 10 Other (specify) SCREEN-PERFORATION INTERVALS: from NA ft. to NA ft., From ft. to ft. GRAVEL PACK INTERVALS: from ft. to ft., From ft. to ft. ft. to ft.	CASING JOINTS: Glued Clamped Welded Threaded Wall thickness or gauge No. 10 Asbestos-cement NA 11 other (specify) 12 None used (open hole)
---	---

6 GROUT MATERIAL: 1 Neat cement 2 Cement grout 3 Bentonite 4 Other Grout Intervals: From 7 ft. to 2 ft., From ft. to ft., From ft. to ft. What is the nearest source of possible contamination: 1 Septic tank 4 Lateral lines 7 Pit privy 10 Livestock pens 14 Abandon water well 2 Sewer lines 5 Cess pool 8 Sewage lagoon 11 Fuel storage 15 Oil well/Gas well 3 Watertight sewer lines 6 Seepage pit 9 Feedyard 12 Fertilizer storage 16 Other (specify below) 13 Insecticide storage
--

Direction from well? West	How many feet? 110
FROM TO LITHOLOGIC LOG	FROM TO PLUGGING INTERVALS
	0 2 clay soil backfill
	2 7 cement grout
	7 15 bentonite hole plug
	15 110 chlorinated sand and gravel

7 CONTRACTOR'S OR LANDOWNER'S CERTIFICATION: This water well was (1) constructed, (2) reconstructed, or (3) plugged under my jurisdiction and was completed on (mo/day/year) 08/04/1992 and this record is true to the best of my knowledge and belief. Kansas Water Well Contractor's License No. 236 This Water Well Record was completed on (mo/day/yr) 08/11/92 Under the business name of Harp Well & Pump Service, Inc. by (signature)

63