WATER WELL PLUGGING RECORD Form WWC-5P KSA 82a-1212

LOCATION OF WATER WELL:	Fraction	Section Number	Township Number	Range Number
Sedgwick	NW ¼ NE ¼ NE ¼	03	26 SOUTH	02 WEST

Distance and direction from nearest town or city street address of well if located within city?
APPROXIMATELY 2.5 MILES NORTH AND 0.75 MILES EAST OF COLWICH, KS

WATER WELL OWNER: ALVIN NEVILLE
RR#, St. Address, Box #: 14601 W. 77TH STREET N.
City, State, ZIP Code: COLWICH, KS 67030

WELL #1 OF BATTERY OF 4 WELLS
Board of Agriculture, Division of Water Resources
Application Number: 37356

MARK WELL'S LOCATION WITH AN "X" IN SECTION BOX

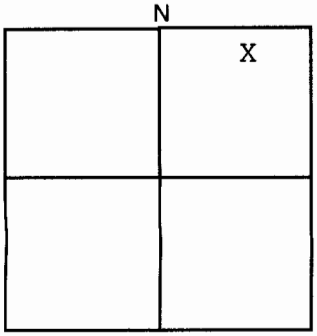

DEPTH OF WELL 44.0 ft.

WELL'S STATIC WATER LEVEL 7.0 ft.

WELL WAS USED AS:

1 Domestic 5 Public Water Supply 9 Dewatering
2 Irrigation 6 Oil Field Water Supply 10 Monitoring Well
3 Feedlot 7 Lawn and Garden Only 11 Injection Well
4 Industrial 8 Air Conditioning 12 Other

Was a chemical/bacteriological sample submitted to Department? Yes ☐ No ☒
If yes, mo/day/yr sample was submitted : / /

Water Well Disinfected: Yes ☒ No ☐

TYPE OF BLANK CASING USED:

1 Steel 3 RMP (SR) 5 Wrought 7 Fiberglass 9 Other
2 PVC 4 ABS 6 Asbestos-Cement 8 Concrete Tile

Blank casing diameter 16.0 in. Was casing pulled? Yes ☐ No ☒ if yes, how much 0.0 ft bls
Casing height ~~above or~~ below land surface 5.0 feet.

GROUT PLUG MATERIAL: 1 Neat cement **2 Cement grout** 3 Bentonite 4 Other

Grout Plug Intervals: From 10.0 ft. to 5.0 ft.

What is the nearest source of possible contamination:

1 Septic tank 6 Seepage pit **11 Fuel Storage** 16 Other
2 Sewer lines 7 Pit privy 12 Fertilizer storage
3 Watertight sewer lines 8 Sewage lagoon 13 Insecticide storage
4 Lateral lines 9 Feedyard 14 Abandoned water well
5 Cess Pool 10 Livestock pens 15 Oil well / Gas well

Direction from well? Southeast How many feet? 430

FROM	TO	PLUGGING MATERIALS
44.0	10.0	CLEAN, COURSE SAND
10.0	5.0	CEMENT
5.0	0	TOPSOIL

NOTE: PARTIAL PLUGGING WITNESSED BY DAVID RANDOLPH, EQUUS BEDS GMD2 ON 12/04/08

CONTRACTOR'S OR LANDOWNER'S CERTIFICATION: This water well was plugged under my jurisdiction and was completed on (mo/day/year) 12 / 06 / 2008 and this record is true to the best of my knowledge and belief. Kansas Water Well Contractor's License No. NA under the business name of N/A
by (signature) Alvin Neville Alvin Neville, owner

INSTRUCTIONS: Use typewriter or ball point pen. Please press firmly and print clearly. Please fill in blanks, and underline or circle the correct answers. Send top three copies to Kansas Department of Health and Environment, Bureau of Water, Topeka, Kansas 66620-0001. Telephone: 913/296-3565. Send one to Water Well Owner and retain one for your records.