


WATER WELL RECORD Form WWC-5 KSA 82a-1212

1 LOCATION OF WATER WELL: Sedgwick	FRACTION SW 1/4 SW 1/4 SW 1/4	SECTION NUMBER 2	TOWNSHIP NUMBER T 26 S	RANGE NUMBER R 2W E/W
---	---	----------------------------	----------------------------------	---------------------------------

Distance and direction from nearest town or city street address of well if located within city?
15210 W. 70th Ct. N. Wichita, Kansas

2 WATER WELL OWNER: **ROBL CONSTRUCTION**
 Board of Agriculture, Division of Water Resource
 RR#,ST. ADDRESS,BOX #: **5842 W. 21st N.**
 CITY, STATE: **Wichita, Kansas** ZIP CODE: _____ Application Number: _____

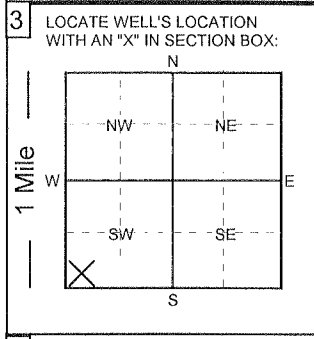

4 DEPTH OF COMPLETED WELL: **84** ft. ELEVATION: _____
 Depth of groundwater Encountered: _____ ft. _____ ft. _____ ft. _____ ft.
 WELL'S STATIC WATER LEVEL **25** FT. BELOW LAND SURFACE MEASURED ON **10/1/15** mo/day/yr:
 Pump test data: Well water was _____ ft. after _____ hours of pumping @ _____ gpm
 Est. Yield: _____ gpm Well water was _____ ft. after _____ hours of pumping @ _____ gpm
 Bore Hole Diameter **12** in. to **84** ft. and _____ in. to _____ ft.
 WELL WATER TO BE USED AS:
 1. Domestic 3. Feedlot 5. Public water supply **7. Lawn and garden only** 9. Dewatering 11. Injection well
 2. Irrigation 4. Industrial 6. Oil field water supply 8. Air conditioning 10. Monitoring well 12. Other (Specify below)
 Was a chemical/bacteriological sample submitted to Department? **YES** **NO**; If yes, what mo/day/yr was sample submitted _____
 Was Water Well Disinfected? **YES** **NO**

5 TYPE OF CASING USED:
 1. Steel 3. RPM (SR) 5. Wrought Iron 7. Fiberglass 9. Other (Specify below) CASING JOINTS: **Glued** Threaded
2. PVC 4. ABS 6. Asbestos-Cement 8. Concrete tile SDR-26 Welded Clamped
 Blank casing diameter **5** in. to **64** ft., Dia. in. to _____ ft., Dia. in. to _____ ft.
 Casing height above land surface: **12** in., Weight: **2.35** lbs. / ft. Wall thickness or gauge No. **.214**
 TYPE OF SCREEN OR PERFORATION MATERIAL:
 1. Steel 3. Stainless Steel 5. Fiberglass **7. PVC** 9. ABS 11. Other (specify) _____
 2. Brass 4. Galvanized 6. Concrete Tile 8. RMP (SR) 10. Asbestos-Cement 12. None used (open hole) _____
 SCREEN OR PERFORATION OPENINGS ARE:
 1. Continuous slot 3. Mill slot 5. Gauzed wrapped 7. Torch cut 9. Drilled holes 11. None (open hole)
 2. Louvered shutter 4. Key punched 6. Wire wrapped **8. Saw cut** 10. Other (specify) _____
 SCREEN - PERFORATION INTERVAL From **64** ft. to **84** ft., From _____ ft. to _____ ft.
 GRAVEL PACK INTERVALS: From **24** ft. to **84** ft., From _____ ft. to _____ ft.

6 GROUT MATERIALS: 1. Neat cement 2. Cement Grout 3. Bentonite Other **bentonite hole plug**
 Grout Intervals: From **4** ft. to **24** ft., From _____ ft. to _____ ft., From _____ ft. to _____ ft.
 What is the nearest source of possible contamination:
 1. Septic tank 4. Lateral lines 7. Pit privy 10. Livestock pens 13. Insecticide storage 15. Oil well/Gas well
 2. Sewer lines 5. Cess Pool 8. Sewage lagoon 11. Fuel storage 14. Abandon water well 16. Other (specify below) _____
 3. Watertight sewer line 6. Seepage pit 9. Feed yard 12. Fertilizer storage **None Yet**
 Direction from well? _____ How many feet? _____

From	To	LITHOLOGIC LOG	From	To	LITHOLOGIC LOG
0	3	topsoil			
3	20	clay and fine sand mix			
20	45	fine sand			
45	60	clay			
60	84	medium sand			

7 Contractor's or Landowner's Certification: This water well was 1. **constructed** 2. reconstructed or 3. plugged under my jurisdiction and was completed on (mo/day/year) **10/1/15** and this record is true to the best of my knowledge and belief.
 Kansas Water Well Contractor's License No. **236** This water well record was completed on (mo/day/year) **10/5/2015**
 under the business name of **Harp Well and Pump Service** by (signature) **Todd S. Harp**