

County: Sedawick Fraction: NE SW SW SW Sec. 15 T. 26 S R. 2 E/W

**CORRECTION(S) to WATER WELL COMPLETION RECORD Form WWC-5 (to rectify lacking or incorrect information)**

Owner: Michelle Woods

If location corrected, was listed as: \_\_\_\_\_ Location changed to: \_\_\_\_\_  
Section-Township-Range: \_\_\_\_\_  
Fraction (1/4 calls): \_\_\_\_\_

Other changes: Initial statements: Height of Well Casing Listed  
WRONG @ 5" + Casing depth is wrong

Changed to: Well casing is 18" TALL  
5" is the diameter of casing to

Comments: Depth of 60' RECEIVED  
Casing height is 18" OCT 12 2018

Verification method: LOG # 1364162 BUREAU OF WATER

Marsena Hilger Initials: MH Date: 10-4-18

Submitted by:  Kansas Geological Survey, Data Resources Library, 1930 Constant Ave., Lawrence, KS 66047-3726  
 Kansas Dept. of Health & Environment, Bureau of Water, 1000 SW Jackson, Suite 420, Topeka, KS 66612-1367

(Revised 09-22-2015)

WATER WELL RECORD Form WWC-5


Original Record Correction Change in Well Use

Division of Water Resources App. No.

Well ID

1 LOCATION OF WATER WELL: County: Sedgwick Fraction NE 1/4 SW 1/4 SW 1/4 SW 1/4 Section Number 15 Township Number T 26 S Range Number R 2 E W

2 WELL OWNER: Last Name: Woods First: Michelle Street or Rural Address where well is located (if unknown, distance and direction from nearest town or intersection): If at owner's address, check here: [X]

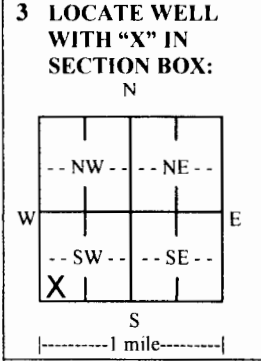

3 LOCATE WELL WITH 'X' IN SECTION BOX: 4 DEPTH OF COMPLETED WELL: 60 ft. Depth(s) Groundwater Encountered: 1) 25 ft. 2) ... ft. 3) ... ft., or 4) [ ] Dry Well

5 Latitude: 37.78042 (decimal degrees) Longitude: 97.53385 (decimal degrees) Datum: [X] WGS 84 [ ] NAD 83 [ ] NAD 27 Source for Latitude/Longitude: [ ] GPS (unit make/model: ... (WAAS enabled? [ ] Yes [ ] No) [ ] Land Survey [ ] Topographic Map [ ] Online Mapper: ...

6 Elevation: 1394 ft. [X] Ground Level [ ] TOC Source: [ ] Land Survey [ ] GPS [ ] Topographic Map [X] Other KOLAR

7 WELL WATER TO BE USED AS: 1. Domestic: [ ] Household [X] Lawn & Garden [ ] Livestock 2. [ ] Irrigation 3. [ ] Feedlot 4. [ ] Industrial 5. [ ] Public Water Supply: well ID ... 6. [ ] Dewatering: how many wells? ... 7. [ ] Aquifer Recharge: well ID ... 8. [ ] Monitoring: well ID ... 9. Environmental Remediation: well ID ... [ ] Air Sparge [ ] Soil Vapor Extraction [ ] Recovery [ ] Injection 10. [ ] Oil Field Water Supply: lease ... 11. Test Hole: well ID ... [ ] Cased [ ] Uncased [ ] Geotechnical 12. Geothermal: how many bores? ... a) Closed Loop [ ] Horizontal [ ] Vertical b) Open Loop [ ] Surface Discharge [ ] Inj. of Water 13. [ ] Other (specify): ...

Was a chemical/bacteriological sample submitted to KDHE? [ ] Yes [X] No If yes, date sample was submitted: ... Water well disinfected? [X] Yes [ ] No

8 TYPE OF CASING USED: [ ] Steel [X] PVC [ ] Other CASING JOINTS: [X] Glued [ ] Clamped [ ] Welded [ ] Threaded Casing diameter 5 in. to 18 ft. Diameter ... in. to ... ft. Diameter ... in. to ... ft. Diameter ... in. to ... ft. Casing height above land surface 18 in. Weight ... lbs./ft. Wall thickness or gauge No. 0.214 TYPE OF SCREEN OR PERFORATION MATERIAL: [ ] Steel [ ] Stainless Steel [ ] Fiberglass [X] PVC [ ] Brass [ ] Galvanized Steel [ ] Concrete tile [ ] None used (open hole) SCREEN OR PERFORATION OPENINGS ARE: [ ] Continuous Slot [ ] Mill Slot [ ] Gauze Wrapped [ ] Torch Cut [ ] Drilled Holes [ ] Other (Specify) ... [ ] Louvered Shutter [ ] Key Punched [ ] Wire Wrapped [X] Saw Cut [ ] None (Open Hole) SCREEN-PERFORATED INTERVALS: From 40 ft. to 60 ft., From ... ft. to ... ft., From ... ft. to ... ft. GRAVEL PACK INTERVALS: From 22 ft. to 60 ft., From ... ft. to ... ft., From ... ft. to ... ft.

9 GROUT MATERIAL: [ ] Neat cement [ ] Cement grout [X] Bentonite [ ] Other Grout Intervals: From 0 ft. to 22 ft., From ... ft. to ... ft., From ... ft. to ... ft., From ... ft. to ... ft. Nearest source of possible contamination: [ ] Septic Tank [ ] Lateral Lines [ ] Pit Privy [ ] Livestock Pens [ ] Insecticide Storage [X] Sewer Lines [ ] Cess Pool [ ] Sewage Lagoon [ ] Fuel Storage [ ] Abandoned Water Well [ ] Watertight Sewer Lines [ ] Seepage Pit [ ] Feedyard [ ] Fertilizer Storage [ ] Oil Well/Gas Well [ ] Other (Specify) ... Direction from well? South Distance from well? 14 ft.

Table with 6 columns: 10 FROM, TO, LITHOLOGIC LOG, FROM, TO, LITHO. LOG (cont.) or PLUGGING INTERVALS. Rows: 0-1 Topsoil, 1-25 Clay, 25-35 Fine Sand, 35-60 Medium Sand.

Notes:

11 CONTRACTOR'S OR LANDOWNER'S CERTIFICATION: This water well was [X] constructed, [ ] reconst.acted, or [ ] plugged under my jurisdiction and was completed on (mo-day-year) 8/21/2017 and this record is true to the best of my knowledge and belief. Kansas Water Well Contractor's License No. 238 This Water Well Record was completed on (mo-day-year) 8/22/2017 under the business name of Premier Pump and Well Service, Inc.