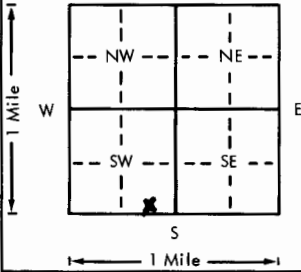


USE TYPEWRITER OR BALL
POINT PEN-PRESS FIRMLY,
PRINT CLEARLY.

WATER WELL RECORD
KSA 82a-1201-1215

Kansas Department of Health and
Environment-Division of Environment
(Water well Contractors)
Topeka, Kansas 66620

1. Location of well:		County Sedgwick	Fraction 1/4 SE 1/4 SW/4	Section number 1	Township number T 26 S R 2 E/W	Range number
2. Distance and direction from nearest town or city: 2-1/4 Mi. N. & 1-1/4 Mi. W. of Maize, Kansas Street address of well location if in city:			3. Owner of well: Bert & Wetta Industries R.R. or street: Maize, Kansas 67101 City, state, zip code:			
4. Locate with "X" in section below: 		Sketch map: Well No. 3		6. Bore hole dia. 30 in. Completion date 11/10/76 Well depth 89 ft.		
5. Type and color of material		From	To	7. ☐ Cable tool ☐ Rotary ☐ Driven ☐ Dug ☐ Hollow rod ☐ Jetted ☐ Bored ☒ Reverse rotary		
Soil		0	2	8. Use: ☐ Domestic ☐ Public supply ☐ Industry ☒ Irrigation ☐ Air conditioning ☐ Stock ☐ Lawn ☐ Oil field water ☐ Other		
Brown clay		2	5	9. Casing: Material <u>steel</u> Height: Above surface Threaded ☐ Welded ☒ Surface 18 in. RMP ☐ PVC ☐ Weight 31.75 lbs./ft. Dia. 16 in. to 41 ft. depth Wall Thickness: inches or Dia. ☐ in. to ☐ ft. depth Gage No. .188		
Silty fine sand		5	10	10. Screen: Manufacturer's name Doerr Metal Products Type ☐ Dia. 16" Slot/gauze 1/8" Length 48" Set between 41 ft. and 89 ft. Gravel pack? yes Size range of material 1/8 x 1/4		
Med. to coarse sand & gravel		10	32	11. Static water level: 5.3 ft. below land surface Date 11/13/76		
Brown clay		32	42	12. Pumping level below land surfaces: 22 ft. after 4 hrs. pumping 948 g.p.m. ☐ ft. after ☐ hrs. pumping ☐ g.p.m. Estimated maximum yield 1200 g.p.m.		
Med. to coarse sand & gravel		42	92	13. Water sample submitted: ☐ Yes ☒ No Date ☐		
				14. Well head completion: ☐ Pitless adapter 18 inches above grade		
				15. Well grouted? yes With: ☐ Neat cement ☐ Bentonite ☒ Concrete Depth: From 0 ft. to 10 ft.		
				16. Nearest source of possible contamination: ft. 1300 Direction West Type Farm Well disinfected upon completion? ☐ Yes ☒ No		
				17. Pump: ☐ Not installed Manufacturer's name Layne WellLine Model number 77267WL HP 75 Volts 480 Length of drop pipe 60 ft. capacity 750 g.p.m. Type: ☐ Submersible ☒ Turbine ☐ Jet ☐ Reciprocating ☐ Centrifugal ☐ Other		
				20. Water well contractor's certification: This well was drilled under my jurisdiction and this report is true to the best of my knowledge and belief. Layne Western Co. 102 Business name 1011 W. Harry, Wichita, KS License No. 1011 Address 1011 W. Harry, Wichita, KS Signed [Signature] Date 11/14/76 Authorized representative		
18. Elevation:		19. Remarks:				
Topography: ☐ Hill ☐ Slope ☒ Upland ☐ Valley						