


Distance and direction from nearest town or city street address of well if located within city?
2 mi. West and 2.5 mi. North of Hwy 296 and Maize Rd

LOCATE WELL'S LOCATION WITH AN "X" IN SECTION BOX: 4 DEPTH OF COMPLETED WELL: 6.5 ft. ELEVATION: 1364.3 GL
Depth(s) Groundwater Encountered 1. 5.2 ft. 2. _____ ft. 3. _____ ft.

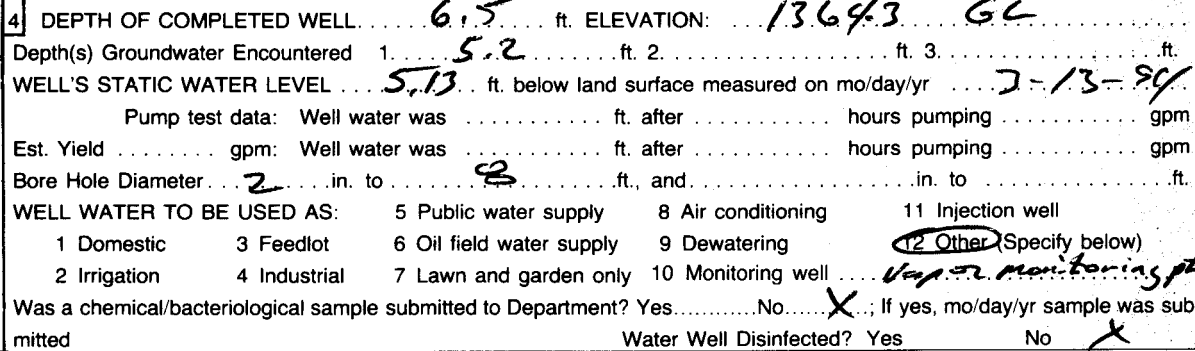

TYPE OF SCREEN OR PERFORATION MATERIAL:

1 Steel	3 Stainless steel	5 Fiberglass	8 RMP (SR)	10 Asbestos-cement
2 Brass	4 Galvanized steel	6 Concrete tile	9 ABS	11 Other (specify)
				12 None used (open hole)

6 GROUT MATERIAL: 1 Neat cement 2 Cement grout 3 Bentonite 4 Other

Grout Intervals: From 1.5 ft. to 3.0 ft. From ft. to ft. From ft. to ft.

FROM	TO	LITHOLOGIC LOG	FROM	TO	PLUGGING INTERVALS
0	1	CLAY			

1	4	sandy silt w/ CLAY			
4	5	CLAY			
5	B	SAND fine to med.			

INSTRUCTIONS: Use typewriter or ball point pen. PLEASE PRESS FIRMLY and PRINT clearly. Please fill in blanks, underline or circle the correct answers. Send top three copies to Kansas Department of Health and Environment, Bureau of Water, Topeka, Kansas 66620-0001. Telephone: 913-296-5545. Send one to WATER WELL OWNER and retain one for your records.