USE TYPEWRITER OR BALL POINT PEN-PRESS FIRMLY, PRINT CLEARLY.

T R EW sec 1/4 1/4 1/4 No.

WATER WELL RECORD
KSA 82a-1201-1215

Kansas State Dept. Of Health
(Water Well Contractors)
Forbes-Bldg. 740
Topeka, Kansas 66620

1 Location of well:	County	Township name	Fraction	Section number	Town number	Range number
	Sedgwick	Union	SW¼ NW¼ SE¼	4	T-26-S	2 W

Distance and direction from nearest town or city:
Street address of well location if in city: 2¼ N, ½ W Colwich

3 Owner of well: Tim Stolz
Address: Colwich, Kansas

Locate with "X" in section below:

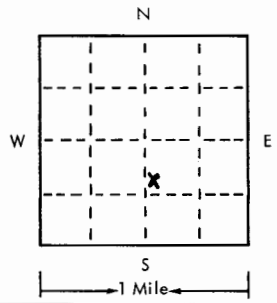

Sketch map: open field

4 Well depth: 92 ft. Date of completion 3/16/76
Well diameter 30 in.

5 ☐ Cable tool ☐ Rotary ☐ Driven ☐ Dug
☐ Hollow rod ☐ Jetted ☐ Bored ☒ Reverse rotary

6 Use: ☐ Domestic ☐ Public supply ☐ Industry
☒ Irrigation ☐ Air conditioning ☐ Commercial
☐ Test well ☐ _____

7 Casing: Material C-Asb. Height: above/below
Threaded ☐ Welded ☐ Surface 12 in.
Diam. Weight 35 lbs./ft. L
16 in. to 92 ft. depth Drive shoe? ☐ Yes ☒ No
___ in. to ___ ft. depth

2 Type and color of material	From	To
Topsoil	0	1
Clay-Gray	1	15
Fine Sand	15	35
Good Gravel	35	92
(use a second sheet if needed)		

8 Screen:
Manufacturer Johnson - Nebr.
Type Cem-Asb. Dia. 16
Slot/gauze 14 Length 52
Set between 40 ft. and 92 ft.
Fittings:
Gravel pack ☒ Yes ☐ No Size range of material 3/8

9 Static water level:
40 ft. below land surface Date 3/12/76

10 Pumping level below land surfaces: no Test
___ ft. after ___ hrs. pumping ___ g.p.m.
___ ft. after ___ hrs. pumping ___ g.p.m.
Estimated maximum yield 1000 g.p.m.

11 Water sample submitted:
☐ Yes ☒ No Date ___

12 Well head completion:
☐ Pitless adapter 18 Inches above grade

13 Well grouted? ☒ Yes ☐ No
☒ Neat cement ☐ Bentonite ☐ _____
Depth: From 0 ft. to 10 ft.

14 Nearest source of possible contamination: irrig
ft. 225 Direction W Type well
Well disinfected upon completion? ☐ Yes ☒ No

15 Pump: ☐ Not installed
Manufacturer's name Peerless
Model number 915752 HP 25 Volts 230
Length of drop pipe 70 ft. capacity 900 g.m.p.
Type:
☐ Submersible ☒ Turbine
☐ Jet ☐ Reciprocating
☐ Certrifugal ☐ Other

16 Remarks: elevation

Topography:
☐ Hill
☐ Slope
☒ Upland
☐ Valley

17 Water well contractor's certification:
This well was drilled under my jurisdiction and this report is true to the best of my knowledge and belief.
Weninger Drilling 238
Business name License No.
Address Maize, Kansas 67101
Signed K. Weninger Date 3/19/76
Authorized representative

Forward the white, blue and pink copies to the Kansas State Dept. Of Health.

Form WWC-5

677-H

26S - 2W - 4
SW-NW-SE