USE TYPEWRITER OR BALL POINT PEN-PRESS FIRMLY, PRINT CLEARLY.

T		R		EW	sec	1/4	1/4	1/4	No.

WATER WELL RECORD
KSA 82a-1201-1215

Kansas State Dept. Of Health
(Water Well Contractors)
Forbes-Bldg. 740
Topeka, Kansas 66620

1 Location of well:	County	Township name	Fraction	Section number	Town number	Range number
	Sedg.	Union	NE/4	5	26S	2W.

Distance and direction from nearest town or city: 1/2 mile East of St. Marks Ks.

Street address of well location if in city:

3 Owner of well: Benjamin Clasen

Address: St. Marks Ks.

Locate with "X" in section below:

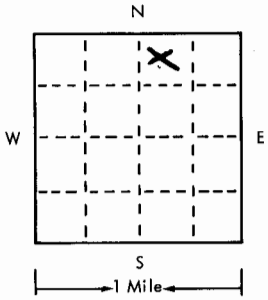

Sketch map:

4 Well depth: 80 ft. Date of completion 6/8
Well diameter 5 in.

5 ☐ Cable tool ☑ Rotary ☐ Driven ☐ Dug
☐ Hollow rod ☐ Jetted ☐ Bored ☐ Reverse rotary

6 Use: ☑ Domestic ☐ Public supply ☐ Industry
☐ Irrigation ☐ Air conditioning ☐ Commercial
☐ Test well ☐

7 Casing: Material plastic Height: above/below
Threaded ☐ Welded ☐ Surface 18 in.
Diam. Weight 1.50 lbs./ft. 100
5 in. to 80 ft. depth Drive shoe? ☐ Yes ☒ No
___ in. to ___ ft. depth

8 Screen:
Manufacturer Jesse Lowell.
Type plastic Dia. 5.
Slot/gauze ___ Length 5
Set between 65 ft. and 80 ft.
Fittings:
Gravel pack ☑ Yes ☐ No Size range of material 3/8

9 Static water level:
38 ft. below land surface Date 6/8

10 Pumping level below land surface:
___ ft. after ___ hrs. pumping ___ g.p.m.
___ ft. after ___ hrs. pumping ___ g.p.m.
Estimated maximum yield 60 g.p.m.

11 Water sample submitted:
☐ Yes ☑ No Date ___

12 Well head completion:
☑ Pitless adapter

13 Well grouted? ☑ Yes ☐ No
☑ Neat cement ☐ Bentonite ☐
Depth: From 3 ft. to 13 ft.

14 Nearest source of possible contamination:
ft. 400 Direction S.E. Type Creek.
Well disinfected upon completion? ☑ Yes ☐ No

15 Pump: ☐ Not installed
Manufacturer's name Valley
Model number 18PN HP 1/2 Volts 230
Length of drop pipe 65 ft. capacity 18 g.m.p.
Type:
☑ Submersible ☐ Turbine
☐ Jet ☐ Reciprocating
☐ Centrifugal ☐ Other

2 Type and color of material	From	To
Bluish gray Clay	0	16
Bluish Shale clayish.	16	40
Shale	40	80

(use a second sheet if needed)

16 Remarks: elevation New Home on upland level.

Topography:
☐ Hill
☐ Slope
☑ Upland
☐ Valley

17 Water well contractor's certification:
This well was drilled under my jurisdiction and this report is true to the best of my knowledge and belief.
Business name Weninger Drilling 238A License No.
Address Maize Ks.
Signed [signature] Date 6/8
Authorized representative

Forward the white, blue and pink copies to the Kansas State Dept. Of Health.

Form WWC-5