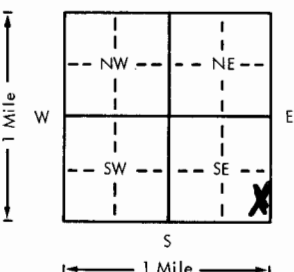
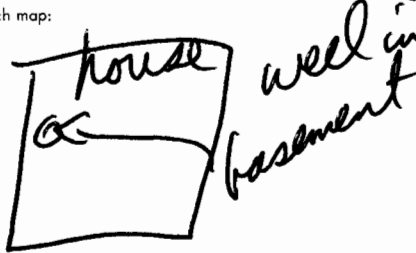


USE TYPEWRITER OR BALL
POINT PEN-PRESS FIRMLY,
PRINT CLEARLY.

WATER WELL RECORD
KSA 82a-1201-1215

Kansas Department of Health and
Environment-Division of Environment
(Water well Contractors)
Topeka, Kansas 66620

1. Location of well: County <u>Sedgewick</u> Fraction <u>SE SE SE</u> Section number <u>9</u> Township number <u>26</u> Range number <u>2</u> <u>EW</u>			
2. Distance and direction from nearest town or city: <u>1 1/4 No. Colwich, KS</u> Street address of well location if in city:		3. Owner of well: <u>Kent Linnebur</u> R.R. or street: <u>ER</u> City, state, zip code: <u>Colwich, KS 67030</u>	
4. Locate with "X" in section below: 		Sketch map: 	
5. Type and color of material		From	To
<u>Top soil</u>		<u>0</u>	<u>2</u>
<u>red clay</u>		<u>2</u>	<u>19</u>
<u>fine sand</u>		<u>19</u>	<u>32</u>
<u>red clay</u>		<u>32</u>	<u>33</u>
<u>med-to-coarse gravel</u>		<u>33</u>	<u>51</u>
6. Bore hole dia. <u>5 1/2</u> in. Completion date <u>3/5/80</u>		Well depth <u>51</u> ft.	
9. Casing: Material <u>Steel</u> Height <u>0</u> Above or below <u>0</u> Threaded <u>X</u> Welded <u>X</u> Surface <u>1/2</u> in. RMP <u>X</u> PVC <u>X</u> Weight <u>1.5</u> lbs./ft. Dia. <u>5</u> in. to <u>5 1/2</u> ft. 
11. Static water level: <u>21</u> ft. below land surface Date <u>3/5/80</u>		12. Pumping level below land surfaces: <u>22</u> ft. after <u>10</u> hrs. pumping <u>10</u> g.p.m. <u>22</u> ft. after <u>10</u> hrs. pumping <u>10</u> g.p.m. Estimated maximum yield <u>50-75</u> g.p.m.	
13. Water sample submitted: <u>Yes</u> <u>X</u> No Date <u>3/5/80</u>		14. Well head completion: <u>12</u> inches above grade Pitless adapter <u>12</u> inches above grade	
15. Well grouted? <u>Yes</u> With: <u>Neat Cement</u> <u>X</u> Bentonite <u>X</u> Concrete <u>X</u> Depth: From <u>10</u> ft. to <u>10</u> ft.		16. Nearest source of possible contamination: <u>None</u> ft. <u>None</u> Direction <u>None</u> Well disinfected upon completion? <u>X</u> Yes <u>X</u> No	
19. Remarks: <u>Water well contractor's certification: This well was drilled under my jurisdiction and this report is true to the best of my knowledge and belief.</u> Business name <u>Wagner's Pumps</u> License No. <u>318</u> Address <u>Colwich, KS</u> Signature <u>Wagner</u> Date <u>3/5/80</u> Authorized representative <u>Wagner</u>		20. Water well contractor's certification: This well was drilled under my jurisdiction and this report is true to the best of my knowledge and belief. Business name <u>Wagner's Pumps</u> License No. <u>318</u> Address <u>Colwich, KS</u> Signature <u>Wagner</u> Date <u>3/5/80</u> Authorized representative <u>Wagner</u>	