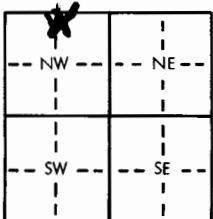
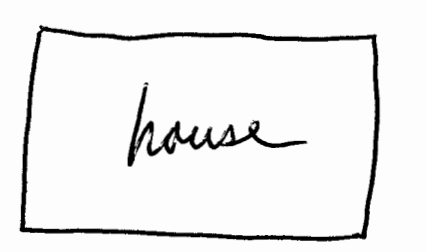


1. Location of well: County <u>Sedgwick</u> Fraction <u>NW 1/4 NE 1/4 NW 1/4</u> Section number <u>12</u> Township number <u>T 26 S</u> Range number <u>R 2 E</u>			
2. Distance and direction from nearest town or city: <u>2 No 2 1/4 E Colwich KS</u>		3. Owner of well: <u>Anna Weninger</u> R.R. or street: <u>701 TROTTER</u> City, state, zip code: <u>Maize KS 67101</u>	
4. Locate with "X" in section below: 		Sketch map: 	
5. Type and color of material		From	To
<u>Top Soil</u>		<u>0</u>	<u>4</u>
<u>Red clay</u>		<u>4</u>	<u>12</u>
<u>med. sand</u>		<u>12</u>	<u>23</u>
<u>red clay</u>		<u>23</u>	<u>24</u>
<u>fine to med. sand</u>		<u>24</u>	<u>35</u>
<u>red clay</u>		<u>35</u>	<u>48</u>
<u>fine sand</u>		<u>48</u>	<u>53</u>
<u>med. to coarse gravel</u>		<u>53</u>	<u>65</u>
18. Elevation:		19. Remarks: <u>Customer to furnish 4x4x4 slab around casing per state Regulations</u> <u>Dennis A. Eck</u>	
20. Water well contractor's certification: This well was drilled under my jurisdiction and this report is true to the best of my knowledge and belief. <u>Weninger Dullay 318</u> Business name <u>Colwich KS</u> Address <u>Maize KS</u> Signature <u>Weninger</u> Date <u>4/6/78</u> Authorized representative			