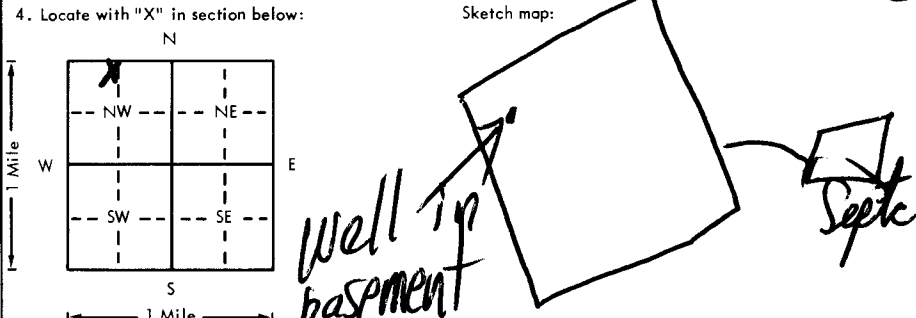


USE TYPEWRITER OR BALL
POINT PEN-PRESS FIRMLY,
PRINT CLEARLY.

WATER WELL RECORD
KSA 82a-1201-1215

Kansas Department of Health and
Environment-Division of Environment
(Water well Contractors)
Topeka, Kansas 66620

1. Location of well: County <u>Sedgwick</u> Fraction <u>NE 1/4 NW 1/4 NW 1/4</u> Section number <u>14</u> Township number <u>T 26</u> Range number <u>S 2 R 20</u>	
2. Distance and direction from nearest town or city: <u>1 No 1 E Colwich KS</u>	
3. Owner of well: <u>Don Linnebur</u> R.R. or street: <u>R#</u> City, state, zip code: <u>Colwich KS 67030</u>	
4. Locate with "X" in section below: Sketch map: 	
5. Type and color of material	
6. Bore hole dia. <u>1 1/2</u> in. Completion date <u>9/20/78</u> Well depth <u>50</u> ft.	
7. ☐ Cable tool ☒ Rotary ☐ Driven ☐ Dug ☐ Hollow rod ☐ Jetted ☐ Bored ☐ Reverse rotary	
8. Use: ☒ Domestic ☐ Public supply ☐ Industry ☐ Irrigation ☐ Air conditioning ☐ Stock ☐ Lawn ☐ Oil field water ☐ Other	
9. Casing: Material <u>Styrene</u> Height <u>0</u> Above or below Threaded ☐ Welded ☒ Surface <u>13</u> in. RMP ☒ PVC ☐ Weight <u>1.50</u> lbs./ft. Dia. <u>5</u> in. <u>50</u> ft. depth Wall thickness: inches or Dia. <u>5</u> in. to <u>50</u> ft. depth gage No. <u>200</u>	
10. Screen: Manufacturer's name <u>Sunflower</u> Type <u>209</u> Dia. <u>5</u> in. Slot/gauge <u>1/16</u> Length <u>2 1/2</u> ft. Set between <u>43</u> ft. and <u>500</u> ft. Gravel pack? <u>yes</u> Size range of material <u>3/8</u> ft.	
11. Static water level: <u>21</u> ft. below land surface Date <u>9/20/78</u>	
12. Pumping level below land surfaces: <u>22</u> ft. after <u>1/2</u> hrs. pumping <u>20</u> g.p.m. <u>22</u> ft. after <u>1/2</u> hrs. pumping <u>20</u> g.p.m. Estimated maximum yield <u>50</u> g.p.m.	
13. Water sample submitted: <u>no.</u> /day/yr. ☐ Yes ☒ No Date <u>9/20/78</u>	
14. Well head completion: <u>12</u> inches above grade ☐ Pitless adapter	
15. Well grouted? <u>yes</u> With: ☐ Neat cement ☐ Bentonite ☒ Concrete Depth: From <u>6</u> ft. to <u>16</u> ft.	
16. Nearest source of possible contamination: <u>Septic</u> ft. <u>100</u> Direction <u>NE</u> Type <u>Septic</u> Well disinfected upon completion? ☒ Yes ☐ No	
17. Pump: ☒ Not installed Manufacturer's name <u>Wenger</u> Model number <u>318</u> HP <u>1</u> Volts <u>115</u> Length of drop pipe <u>1</u> ft. capacity <u>1</u> g.p.m. Type: ☐ Submersible ☐ Turbine ☐ Jet ☐ Reciprocating ☐ Centrifugal ☐ Other	
18. Elevation: <u>26</u> - <u>20</u> - <u>14</u> NE NW NW Topography: ☒ Hill ☐ Slope ☐ Upland ☐ Valley	
19. Remarks: <u>well tip basement</u>	
20. Water well contractor's certification: This well was drilled under my jurisdiction and this report is true to the best of my knowledge and belief. <u>Wenger Drilling 318</u> Business name <u>Colwich</u> License No. <u>1</u> Address <u>Colwich</u> State <u>KS</u> Date <u>9/20/78</u> Signature <u>Joe Wenger</u> Authorized representative	

Forward the white, blue and pink copies to the Department of Health and Environment

Form WWC-5