USE TYPEWRITER OR BALL POINT PEN-PRESS FIRMLY, PRINT CLEARLY.

WATER WELL RECORD
KSA 82a-1201-1215

Kansas Department of Health and Environment-Division of Environment
(Water well Contractors)
Topeka, Kansas 66620

1. Location of well:	County	Fraction	Section number	Township number	Range number
	SEDGWICK	NE 1/4 SE 1/4	16	T 26 S	R 2W E/W

2. Distance and direction from nearest town or city:
Street address of well location if in city: 202 East Wichita Colwich, Kansas

3. Owner of well:
R.R. or street: Consolidated Farmers Mutual Ins. Co.
City, state, zip code: 202 East Wichita, Colwich, Kansas

4. Locate with "X" in section below:

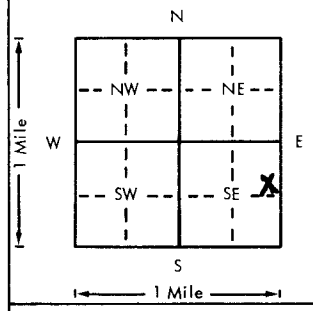

Sketch map:

6. Bore hole dia. 11 in. Completion date
Well depth 60 ft. 2-15-78

7. __ Cable tool X Rotary __ Driven __ Dug
__ Hollow rod __ Jetted __ Bored __ Reverse rotary

8. Use: __ Domestic __ Public supply __ Industry
__ Irrigation X Air conditioning __ Stock
__ Lawn __ Oil field water __ Other

9. Casing: Material PVC Height: Above or ~~below~~
Threaded __ Welded __ Surface 12 in.
RMP __ PVC X Weight 3.96 lbs./ft.
Dia. 6 in. to 60 ft. depth Wall Thickness: inches or
Dia. __ in. to __ ft. depth gage No. .316

5. Type and color of material	From	To
Topsoil	0	3
Clay	3	35
Fine Sand	35	45
Medium Sand	45	60

10. Screen: Manufacturer's name PVC NSF Approved 200PSI
Type PVC 200 PSI Dia. 6"
Slot/~~dapze~~ 06 Length 15'
Set between 45 ft. and 60 ft.
__ ft. and __ ft.
Gravel pack yes Size range of material ¼-1/8"

11. Static water level: mo./day/yr.
30 ft. below land surface Date 2-15-78

12. Pumping level below land surfaces:
__ ft. after __ hrs. pumping __ g.p.m.
__ ft. after __ hrs. pumping __ g.p.m.
Estimated maximum yield __ g.p.m.

13. Water sample submitted: mo./day/yr.
__ Yes __ No Date

14. Well head completion:
X Pitless adapter 12 Inches above grade

15. Well grouted? yes 1-2 fine sand mix
With: __ Neat cement __ Bentonite X Concrete
Depth: From 40" ft. to 14 ft.

16. Nearest source of possible contaminotion: NONE
ft. __ Direction __ Type __
Well disinfected upon completion? X Yes __ No

17. Pump: __ Not installed
Manufocturer's name Hydraulic Products
Model number T100 50 HP 3/4 Volts 230
Length of drop pipe __ ft. capacity 18 g.p.m.
Type:
X Submersible __ Turbine
__ Jet __ Reciprocating
__ Centrifugal __ Other

(Use a second sheet if needed)

18. Elevation:

Topography:
__ Hill
__ Slope
__ Upland
__ Valley

19. Remarks: Flat Ground

20. Water well contractor's certification:
This well was drilled under my jurisdiction and this report is true to the best of my knowledge and belief.
Harp Well & Pump 236
Business name Wichita, Kansas License No.
Address
Signed M. Arnold Date 4-24-78
Authorized representative

T 26 — R 2W E — Sec 16 — 1/4 NESE 1/4 1/4

Forward the white, blue ond pink copies to the Department of Health and Environment

Form WWC-5

MI-1023