

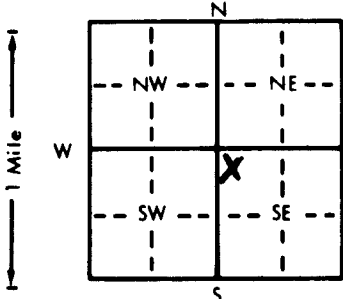
1 LOCATION OF WATER WELL:	Fraction	Section Number	Township Number	Range Number
County: <u>Sedgwick</u>	<u>NW 1/4 NW 1/4 SE 1/4</u>	<u>10</u>	<u>T 26 S</u>	<u>R 2 E</u>

Distance and direction from nearest town or city street address of well if located within city?

725 Brookside, Colwich ks.

2 WATER WELL OWNER:	Joe Scheer	Board of Agriculture, Division of Water Resources
RR#, St. Address, Box # :	725 Brookside	Application Number:
City, State, ZIP Code :	Colwich Ks. 67030	

3 LOCATE WELL'S LOCATION WITH AN "X" IN SECTION BOX:	4 DEPTH OF COMPLETED WELL: 60 ft. ELEVATION:
--	--

Depth(s) Groundwater Encountered 1. 24 ft. 2. 24 ft. 3. 20 ft.WELL'S STATIC WATER LEVEL 24 ft. below land surface measured on mo/day/yr 5-12-88Pump test data: Well water was 24 ft. after 12 hours pumping 20 gpmEst. Yield 50 gpm: Well water was 24 ft. after 12 hours pumping 20 gpmBore Hole Diameter 11 in. to 60 ft., and 11 in. to 60 ft.

WELL WATER TO BE USED AS:

1 Domestic	3 Feedlot	6 Oil field water supply	9 Dewatering	12 Other (Specify below)
2 Irrigation	4 Industrial	7 Lawn and garden only	10 Observation well	

Was a chemical/bacteriological sample submitted to Department? Yes No If yes, mo/day/yr sample was submittedWater Well Disinfected? Yes No

5 TYPE OF BLANK CASING USED:	5 Wrought iron	8 Concrete tile	CASING JOINTS: Glued <u>Clamped</u>
------------------------------	----------------	-----------------	-------------------------------------

1 Steel 3 RMP (SR) 6 Asbestos-Cement 9 Other (specify below) Welded2 PVC 4 ABS 7 Fiberglass ThreadedBlank casing diameter 5 in. to 50 ft., Dia 1.59 in. to 50 ft., Dia 1.59 in. to 50 ft.Casing height above land surface 12 in., weight 1.59 lbs./ft. Wall thickness or gauge No. SPE-26

TYPE OF SCREEN OR PERFORATION MATERIAL:	7 PVC	10 Asbestos-cement
---	-------	--------------------

1 Steel 3 Stainless steel 5 Fiberglass 8 RMP (SR) 11 Other (specify)

2 Brass 4 Galvanized steel 6 Concrete tile 9 ABS 12 None used (open hole)

SCREEN OR PERFORATION OPENINGS ARE:	5 Gauzed wrapped	8 Saw cut	11 None (open hole)
-------------------------------------	------------------	-----------	---------------------

1 Continuous slot 3 Mill slot 6 Wire wrapped 9 Drilled holes

2 Louvered shutter 4 Key punched 7 Torch cut 10 Other (specify)

SCREEN-PERFORATED INTERVALS:	From <u>50</u> ft. to <u>60</u> ft.	From <u>50</u> ft. to <u>60</u> ft.
------------------------------	-------------------------------------	-------------------------------------

From 50 ft. to 60 ft. From 50 ft. to 60 ft.GRAVEL PACK INTERVALS: From 23 ft. to 60 ft. From 23 ft. to 60 ft.From 23 ft. to 60 ft. From 23 ft. to 60 ft.

6 GROUT MATERIAL:	1 Neat cement	2 Cement grout	3 Bentonite	4 Other
-------------------	---------------	----------------	-------------	---------

Grout intervals: From 3 ft. to 23 ft. From 3 ft. to 23 ft.

What is the nearest source of possible contamination:

1 Septic tank 4 Lateral lines 7 Pit privy 10 Livestock pens 14 Abandoned water well

2 Sewer lines 5 Cess pool 8 Sewage lagoon 11 Fuel storage 15 Oil well/Gas well

3 Watertight sewer lines 6 Borehole pit 9 Feedyard 12 Fertilizer storage 16 Other (specify below)

13 Insecticide storage

Direction from well? North How many feet? 80

FROM	TO	LITHOLOGIC LOG	FROM	TO	LITHOLOGIC LOG
------	----	----------------	------	----	----------------

0 2 Top soil

2 18 Clay

18 32 fine sand

32 23 Clay

33 60 fine to med sand