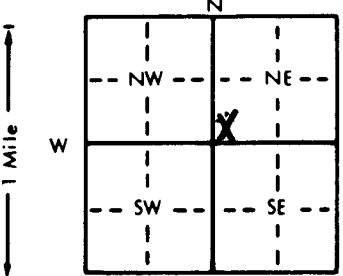


1 LOCATION OF WATER WELL:		Fraction	Section Number	Township Number	Range Number
County: <u>Sequoyia</u> <u>SW</u> <u>1/4</u> <u>SW</u> <u>1/4</u> <u>NE</u> <u>1/4</u>		<u>16</u>	<u>16</u>	<u>26</u> S	<u>2</u> E/W
Distance and direction from nearest town or city street address of well if located within city?					
<u>See Below</u>					
2 WATER WELL OWNER: <u>Linus Schwartz</u>					
RR#, St. Address, Box #: <u>412 N. Colorado</u>					
City, State, ZIP Code: <u>Colwich KS 67030</u>					
Board of Agriculture, Division of Water Resources					
Application Number:					
3 LOCATE WELL'S LOCATION WITH AN "X" IN SECTION BOX:		4 DEPTH OF COMPLETED WELL: <u>65</u> ft. ELEVATION:			
		Depth(s) Groundwater Encountered 1 <u>28</u> ft. 2 <u>28</u> ft. 3 <u>9-6-91</u> ft.			
		WELL'S STATIC WATER LEVEL <u>28</u> ft. below land surface measured on mo/day/yr			
		Pump test data: Well water was <u>28</u> ft. after <u>12</u> hours pumping <u>20</u> gpm			
		Est. Yield <u>60</u> gpm: Well water was <u>28</u> ft. after <u>12</u> hours pumping <u>20</u> gpm			
		Bore Hole Diameter <u>11</u> in. to <u>65</u> ft. and <u>65</u> in. to <u>65</u> ft.			
		WELL WATER TO BE USED AS:			
		1 Domestic 3 Feedlot 5 Public water supply 8 Air conditioning 11 Injection well			
		2 Irrigation 4 Industrial 6 Oil field water supply 9 Dewatering 12 Other (Specify below)			
		7 Lawn and garden only 10 Monitoring well			
		Was a chemical/bacteriological sample submitted to Department? Yes <u>X</u> No <u>X</u> If yes, mo/day/yr sample was submitted			
		Water Well Disinfected? Yes <u>X</u> No <u>X</u>			
5 TYPE OF BLANK CASING USED:					
1 Steel 3 RMP (SR) 5 Wrought iron 8 Concrete tile CASING JOINTS: Glued <u>X</u> Clamped <u>X</u>					
2 PVC 4 ABS 6 Asbestos-Cement 9 Other (specify below) Welded <u>X</u>					
Blank casing diameter <u>5</u> in. to <u>58</u> ft. Dia <u>258</u> in. to <u>160</u> ft. Dia <u>160</u> in. to <u>160</u> ft.					
Casing height above land surface <u>12</u> in. weight <u>258</u> lbs./ft. Wall thickness or gauge No. <u>160</u>					
TYPE OF SCREEN OR PERFORATION MATERIAL:					
1 Steel 3 Stainless steel 5 Fiberglass 8 RMP (SR) 11 Other (specify)					
2 Brass 4 Galvanized steel 6 Concrete tile 9 ABS 12 None used (open hole)					
SCREEN OR PERFORATION OPENINGS ARE:					
1 Continuous slot 3 Mill slot 5 Gauzed wrapped 8 Saw cut 11 None (open hole)					
2 Louvered shutter 4 Key punched 6 Wire wrapped 9 Drilled holes					
7 Torch cut 10 Other (specify)					
6 GROUT MATERIAL:					
1 Neat cement 2 Cement grout 3 Bentonite 4 Other					
What is the nearest source of possible contamination:					
1 Septic tank 4 Lateral lines 7 Pit privy 10 Livestock pens 14 Abandoned water well					
2 Sewer lines 5 Cess pool 8 Sewage lagoon 11 Fuel storage 15 Oil well/Gas well					
3 Watertight sewer lines 6 Seepage pit 9 Feedyard 12 Fertilizer storage 16 Other (specify below)					
13 Insecticide storage					
Direction from well? <u>EAST</u> How many feet? <u>25</u>					
FROM		TO		LITHOLOGIC LOG	
FROM		TO		PLUGGING INTERVALS	
0		2		top soil	
2		21		clay	
21		36		fine Sand	
36		39		clay	
39		65		fine to med. Sand	
7 CONTRACTOR'S OR LANDOWNER'S CERTIFICATION: This water well was (1) constructed, (2) reconstructed, or (3) plugged under my jurisdiction and was completed on (mo/day/year) <u>9-6-91</u> and this record is true to the best of my knowledge and belief. Kansas					
Water Well Contractor's License No. <u>318</u> This Water Well Record was completed on (mo/day/yr) <u>9-6-91</u>					
under the business name of <u>Wentzel Drilling Co.</u> by (signature) <u>[Signature]</u>					
INSTRUCTIONS: Use typewriter or ball point pen. PLEASE PRESS FIRMLY and PRINT clearly. Please fill in blanks, underline or circle correct answers. Send top three copies to Kansas Department of Health and Environment, Bureau of Water, Topeka, Kansas 66620-7320. Telephone 913-296-5545. Send one to WATER WELL OWNER and retain one for your records.					

OFFICE USE ONLY

T

R

EW

SEC.

1/4

1/4

1/4