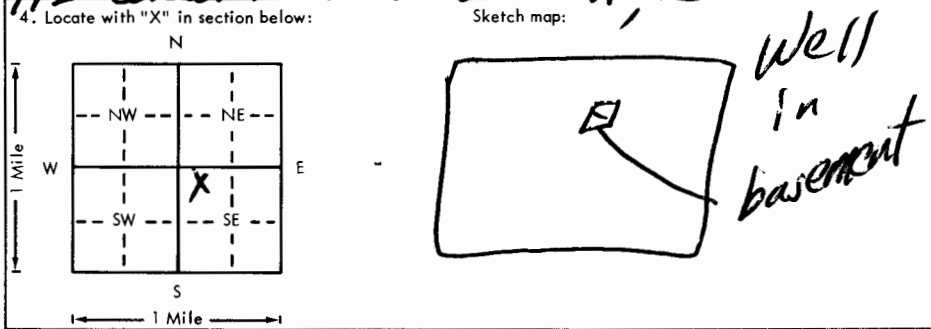


USE TYPEWRITER OR BALL POINT PEN—PRESS FIRMLY, PRINT CLEARLY.

WATER WELL RECORD
KSA 82a-1201-1215

Kansas Department of Health and Environment—Division of Environment
(Water well Contractors)
Topeka, Kansas 66620

SW NW SW SE

1. Location of well: County <u>Sedgwick</u> Fraction <u>NE 1/4 NW 1/4 SE 1/4</u> Section number <u>16</u> Township number T <u>26</u> S Range number R <u>2</u> EW																			
2. Distance and direction from nearest town or city: Street address of well location if in city: <u>112 Centennial Ct. Colwich, KS</u>																			
3. Owner of well: <u>Steve Lee Const.</u> R.R. or street: <u>6110 Bella Rd</u> City, state, zip code: <u>Wichita KS 67204</u>																			
4. Locate with "X" in section below: Sketch map:  Well in basement																			
5. Type and color of material																			
<table border="1"> <thead> <tr> <th></th> <th>From</th> <th>To</th> </tr> </thead> <tbody> <tr> <td>Top soil.</td> <td>0</td> <td>2</td> </tr> <tr> <td>red clay.</td> <td>2</td> <td>16</td> </tr> <tr> <td>fine to med sand</td> <td>16</td> <td>32</td> </tr> <tr> <td>red clay</td> <td>32</td> <td>33</td> </tr> <tr> <td>med. to coarse gravel</td> <td>33</td> <td>52</td> </tr> </tbody> </table>			From	To	Top soil.	0	2	red clay.	2	16	fine to med sand	16	32	red clay	32	33	med. to coarse gravel	33	52
	From	To																	
Top soil.	0	2																	
red clay.	2	16																	
fine to med sand	16	32																	
red clay	32	33																	
med. to coarse gravel	33	52																	
6. Bore hole dia. <u>5 1/2</u> in. Completion date: Well depth <u>52</u> ft. <u>4/13/79</u>																			
7. <input checked="" type="checkbox"/> Cable tool <input checked="" type="checkbox"/> Rotary <input type="checkbox"/> Driven <input type="checkbox"/> Dug <input type="checkbox"/> Hollow rod <input type="checkbox"/> Jetted <input type="checkbox"/> Bored <input type="checkbox"/> Reverse rotary																			
8. Use: <input checked="" type="checkbox"/> Domestic <input type="checkbox"/> Public supply <input type="checkbox"/> Industry <input type="checkbox"/> Irrigation <input type="checkbox"/> Air conditioning <input type="checkbox"/> Stock <input type="checkbox"/> Law <input type="checkbox"/> Oil field water <input type="checkbox"/> Other																			
9. Casing: Material <u>Styrene</u> Weight <u>12</u> Above or below Threading <u>Welded</u> Surface <u>12</u> in. RMP <input checked="" type="checkbox"/> PVC Weight <u>1.50</u> lbs./ft. Dia. <u>5 1/2</u> in. to <u>52</u> ft. depth Wall Thickness: inches or Dia. <u>200</u> in. to <u>200</u> ft. depth gage No. <u>200</u>																			
10. Screen: Manufacturer's name <u>Sunflower</u> Type <u>200</u> Dia. <u>5 1/2</u> slot/gauge <u>1/16</u> Length <u>6 ft</u> Set between <u>40</u> ft. and <u>52</u> ft. Gravel pack? <u>Yes</u> size range of material <u>3/8</u>																			
11. Static water level: <u>17</u> ft. below land surface Date <u>4/13/79</u> mp./day/yr																			
12. Pumping level below land surfaces: <u>20</u> ft. after <u>1</u> hrs. pumping <u>15</u> g.p.m. <u>30-40</u> g.p.m. Estimated maximum yield <u>30-40</u> g.p.m.																			
13. Water sample submitted: <u>X</u> Yes <u>X</u> No Date _____ mo./day/yr.																			
14. Well head completion: <u>12</u> Pitless adapter <u>12</u> inches above grade																			
15. Well grouted? <u>Yes</u> With: <u>Neat cement</u> <u>Bentonite</u> <input checked="" type="checkbox"/> Concrete Depth: From <u>6</u> ft. to <u>16</u> ft.																			
16. Nearest source of possible contamination: <u>N</u> ft. Direction <u>30</u> Type <u>Ally</u> Well disinfected upon completion? <input checked="" type="checkbox"/> Yes <input type="checkbox"/> No																			
17. Pump: <input checked="" type="checkbox"/> Not installed Manufacturer's name _____ HP _____ Volts _____ Length of drop pipe _____ ft. capacity _____ g.p.m. Type: <input type="checkbox"/> Submersible <input type="checkbox"/> Turbine <input type="checkbox"/> Jet <input type="checkbox"/> Reciprocating <input type="checkbox"/> Centrifugal <input type="checkbox"/> Other																			
(Use a second sheet if needed)																			
18. Elevation: Topography: <input type="checkbox"/> Hill <input type="checkbox"/> Slope <input checked="" type="checkbox"/> Upland <input type="checkbox"/> Valley	19. Remarks: <u>New Construction</u>																		
20. Water well contractor's certification: This well was drilled under my jurisdiction and this report is true to the best of my knowledge and belief. <u>Wagner Dilling 318</u> Business name License No. <u>Church St</u> Address <u>Wagner</u> Signature <u>4/14/79</u> Authorized representative																			

Forward the white, blue and pink copies to the Department of Health and Environment

Form WWC-5