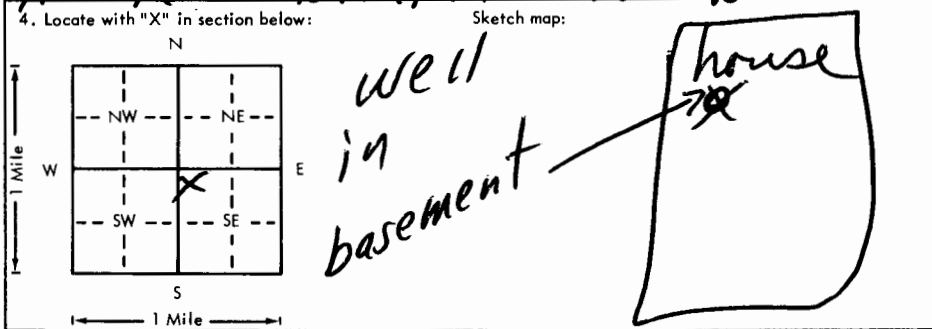


USE TYPEWRITER OR BALL
POINT PEN—PRESS FIRMLY,
PRINT CLEARLY.

WATER WELL RECORD
KSA 82a-1201-1215

Kansas Department of Health and
Environment—Division of Environment
(Water well Contractors)
Topeka, Kansas 66620

1. Location of well: County: <u>Sedgwick</u> Fraction: <u>NW 1/4 NW 1/4 SE 1/4</u> Section number: <u>16</u> Township number: <u>26</u> S Range number: <u>2</u> E	
2. Distance and direction from nearest town or city: Street address of well location in city: <u>110 No. Centennial Pl Colwich Ks</u>	
3. Owner of well: <u>Mark Sueltenfrop Const.</u> R.R. or street: <u>632 Sec. 11e</u> City, state, zip code: <u>Wichita KS 67212</u>	
4. Locate with "X" in section below: Sketch map: 	
5. Type and color of material	
6. Bore hole dia. <u>11</u> in. Completion date <u>3/10/80</u> Well depth <u>50</u> ft.	
7. ☒ Cable tool ☒ Rotary ☐ Driven ☐ Dug ☐ Hollow rod ☐ Jetted ☐ Bored ☐ Reverse rotary	
8. Use: ☒ Domestic ☐ Public supply ☐ Industry ☐ Irrigation ☐ Air conditioning ☐ Stock ☐ Lawn ☐ Oil field water ☐ Other	
9. Casing: Material <u>Steel</u> Weight <u>9</u> lbs./ft. Above or below Threaded ☐ Welded ☒ Surface ☐ in. RMP ☒ PVC ☐ Weight <u>1.50</u> lbs./ft. Dia. <u>5</u> in. to <u>50</u> ft. depth Wall Thickness <u>1/2</u> inches Dia. <u>5</u> in. to <u>50</u> ft. depth gage No. <u>200</u>	
10. Screen: Manufacturer's name <u>Cer-mac</u> Type <u>200</u> Dia. <u>5</u> in. Slot/gauze <u>1/16</u> Length <u>10</u> ft. Set between <u>40</u> ft. and <u>50</u> ft. Gravel pack <u>yes</u> Size range of material <u>18-38</u>	
11. Static water level: <u>24</u> ft. below land surface Date <u>3/10/80</u> 12. Pumping level below land surfaces: <u>25</u> ft. after <u>1/2</u> hrs. pumping <u>15</u> g.p.m. <u>25</u> ft. after <u>1/2</u> hrs. pumping <u>15</u> g.p.m. Estimated maximum yield <u>50</u> g.p.m.	
13. Water sample submitted: <u>Yes</u> ☒ No ☐ Date <u>3/10/80</u>	
14. Well head completion: <u>12</u> Pitless adapter <u>12</u> inches above grade	
15. Well grouted? <u>yes</u> With: <u>Neat cement</u> ☐ Bentonite ☒ Concrete ☐ Depth: From <u>6</u> ft. to <u>16</u> ft.	
16. Nearest source of possible contamination: ft. <u>None</u> Type <u>None</u> Well disinfected upon completion? ☒ Yes ☐ No	
(Use a second sheet if needed)	
18. Elevation: Topography: ☒ Hill ☐ Slope ☐ Upland ☐ Valley	19. Remarks:
20. Water well contractor's certification: This well was drilled under my jurisdiction and this report is true to the best of my knowledge and belief. <u>Wenger Kelly</u> 318 Business name <u>Colwich</u> License No. <u>318</u> Address <u>Colwich</u> Date <u>3/10/80</u> Signature <u>Wenger</u> Authorized representative	

Forward the white, blue and pink copies to the Department of Health and Environment

Form WWC-5