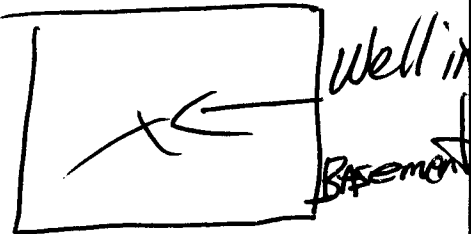


USE TYPEWRITER OR BALL
POINT PEN-PRESS FIRMLY,
PRINT CLEARLY.

WATER WELL RECORD
KSA 82a-1201-1215

Kansas Department of Health and
Environment-Division of Environment
(Water well Contractors)
Topeka, Kansas 66620

NW NW SW SE

1. Location of well:		County <u>Sedg.</u>	Fraction <u>1/4 NW 1/4 Sec 16</u>	Section number <u>16</u>	Township number <u>T 26 S</u>	Range number <u>R 2 E</u>																					
2. Distance and direction from nearest town or city: Street address of well location if in city: <u>100 Centennial Colwich St.</u>				3. Owner of well: <u>Steve Lee Const.</u> R.R. or street: <u>2421 W. 25th no</u> City, state, zip code: <u>Wichita KS 67204</u>																							
4. Locate with "X" in section below: N W E S 1 Mile		Sketch map: 		6. Bore hole dia. <u>11</u> in. Completion date <u>11/2/77</u> Well depth <u>51</u> ft.																							
5. Type and color of material				7. ☒ Cable tool ☒ Rotary ☐ Driven ☐ Dug ☐ Hollow rod ☐ Jetted ☐ Bored ☐ Reverse rotary																							
<table border="1"><thead><tr><th></th><th>From</th><th>To</th></tr></thead><tbody><tr><td><u>Top soil</u></td><td><u>0</u></td><td><u>4</u></td></tr><tr><td><u>Red clay.</u></td><td><u>4</u></td><td><u>18</u></td></tr><tr><td><u>medium Sand.</u></td><td><u>18</u></td><td><u>36</u></td></tr><tr><td><u>clay.</u></td><td><u>36</u></td><td><u>37</u></td></tr><tr><td><u>GRADE 1.</u></td><td><u>37</u></td><td><u>50</u></td></tr><tr><td><u>clay.</u></td><td><u>50</u></td><td><u>51</u></td></tr></tbody></table>					From	To	<u>Top soil</u>	<u>0</u>	<u>4</u>	<u>Red clay.</u>	<u>4</u>	<u>18</u>	<u>medium Sand.</u>	<u>18</u>	<u>36</u>	<u>clay.</u>	<u>36</u>	<u>37</u>	<u>GRADE 1.</u>	<u>37</u>	<u>50</u>	<u>clay.</u>	<u>50</u>	<u>51</u>	8. Use ☒ Domestic ☐ Public supply ☐ Industry ☐ Irrigation ☐ Air conditioning ☐ Stock ☐ Lawn ☐ Oil field water ☐ Other		
					From	To																					
<u>Top soil</u>	<u>0</u>	<u>4</u>																									
<u>Red clay.</u>	<u>4</u>	<u>18</u>																									
<u>medium Sand.</u>	<u>18</u>	<u>36</u>																									
<u>clay.</u>	<u>36</u>	<u>37</u>																									
<u>GRADE 1.</u>	<u>37</u>	<u>50</u>																									
<u>clay.</u>	<u>50</u>	<u>51</u>																									
				9. Casing: Material <u>AS</u> Height <u>Above</u> or below Threaded ☐ Welded ☒ Surface <u>1 1/2</u> in. RMP ☐ PVC ☒ Weight <u>2.31</u> lbs./ft. Dia. <u>5</u> in. to <u>51</u> ft. depth Wall thickness: inches or Dia. <u>5</u> in. to <u>51</u> ft. depth gage No. <u>214</u>																							
				10. Screen: Manufacturer's name <u>M.P.I.</u> Type <u>PVC</u> Dia. <u>5 1/2</u> in. Slot gauge <u>1/16</u> Length <u>5</u> ft. Set between <u>1/4</u> ft. and <u>3/4</u> ft. Gravel pack? <u>yes</u> Size range of material <u>3/8</u>																							
				11. Static water level: <u>22</u> ft. below land surface Date <u>11/2/77</u> Date <u>11/2/77</u>																							
				12. Pumping level below land surfaces: <u>23</u> ft. after <u>1/2</u> hrs. pumping <u>20</u> g.p.m. <u>23</u> ft. after <u>1/2</u> hrs. pumping <u>20</u> g.p.m. Estimated maximum yield <u>100</u> g.p.m.																							
				13. Water sample submitted: <u>yes</u> Date <u>11/2/77</u>																							
				14. Well head completion: ☐ Pitless adapter <u>12</u> inches above grade																							
				15. Well grouted? <u>yes</u> With: ☒ Neat cement ☐ Bentonite ☐ Concrete Depth: From <u>4</u> ft. to <u>16</u> ft.																							
				16. Nearest source of possible contamination: ft. <u>None</u> Direction <u>None</u> Type <u>None</u> Well disinfected upon completion? ☒ Yes ☐ No																							
				17. Pump: ☒ Not installed Manufacturer's name <u>None</u> Model number <u>None</u> HP <u>None</u> Volts <u>None</u> Length of drop pipe <u>None</u> ft. capacity <u>None</u> g.p.m. Type: ☐ Submersible ☐ Turbine ☐ Jet ☐ Reciprocating ☐ Centrifugal ☐ Other																							
18. Elevation:		19. Remarks:		20. Water well contractor's certification: This well was drilled under my jurisdiction and this report is made to the best of my knowledge and belief. Business name <u>Weninger Drilling</u> License No. <u>318</u> Address <u>Colwich KS</u> Signed <u>John Weninger</u> Date <u>11/2/77</u> Authorized representative																							

Forward the white, blue and pink copies to the Department of Health and Environment

Form WWC-5