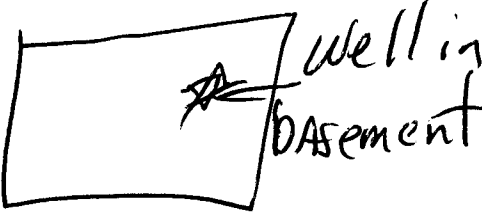


USE TYPEWRITER OR BALL
POINT PEN-PRESS FIRMLY,
PRINT CLEARLY.

WATER WELL RECORD
KSA 82a-1201-1215

Kansas Department of Health and
Environment-Division of Environment
(Water well Contractors)
Topeka, Kansas 66620

NW NW SW SE

1. Location of well: County <u>Sedgwick</u> Fraction <u>1/4 NW 1/4 SW 1/4</u> Section number <u>16</u> Township number <u>T 26 S R 2 E</u> Range number <u>2</u>	
2. Distance and direction from nearest town or city: Street address of well location in city: <u>104 Centennial Colwich KS</u>	
3. Owner of well: <u>Steve Lee Const.</u> R.R. or street: <u>2421 W. 25th NO</u> City, state, zip code: <u>Wichita KS 67204</u>	
4. Locate with "X" in section below: Sketch map: 	
5. Type and color of material	
6. Bore hole dia. <u>58</u> in. Completion date <u>2/3/78</u> Well depth <u>58</u> ft.	
7. ☒ Cable tool ☒ Rotary ☐ Driven ☐ Dug ☐ Hollow rod ☐ Jetted ☐ Bored ☐ Reverse rotary	
8. Use: ☒ Domestic ☐ Public supply ☐ Industry ☐ Irrigation ☐ Air conditioning ☐ Stock ☐ Lawn ☐ Oil field water ☐ Other	
9. Casing: Material <u>AL</u> Height: Above or below Threaded ☐ Welded ☒ Surface <u>12</u> in. RMP ☐ PVC ☒ Weight <u>2.76</u> lbs./ft. Dia. <u>5</u> in. to <u>58</u> ft. depth Wall Thickness: inches or Dia. <u>58</u> in. to <u>58</u> ft. depth gage No. <u>258</u>	
10. Screen: Manufacturer's name <u>M.P.E.</u> Type <u>PVC</u> Dia. <u>5</u> in. Slot gauge <u>11/16</u> Length <u>10</u> ft. Set between <u>48</u> ft. and <u>58</u> ft. Gravel pack? <u>Yes</u> Size range of material <u>3/8</u>	
11. Static water level: <u>21</u> ft. below land surface Date <u>2/3/78</u>	
12. Pumping level below land surfaces: <u>22</u> ft. after <u>12</u> hrs. pumping <u>20</u> g.p.m. <u> </u> ft. after <u> </u> hrs. pumping <u> </u> g.p.m. Estimated maximum yield <u>75</u> g.p.m.	
13. Water sample submitted: <u> </u> mo./day/yr. Yes ☒ No ☐ Date <u> </u>	
14. Well head completion: <u> </u> Pitless adapter <u>12</u> inches above grade	
15. Well grouted? <u>Yes</u> With: <u> </u> Neat cement <u> </u> Bentonite ☒ Concrete Depth: From <u>6</u> ft. to <u>16</u> ft.	
16. Nearest source of possible contamination: ft. <u>500</u> Direction <u>West</u> Type <u>Creek</u> Well disinfected upon completion? ☒ Yes ☐ No	
17. Pump: ☒ Not installed Manufacturer's name <u> </u> Model number <u> </u> HP <u> </u> Volts <u> </u> Length of drop pipe <u> </u> ft. capacity <u> </u> g.p.m. Type: ☐ Submersible ☐ Turbine ☐ Jet ☐ Reciprocating ☐ Centrifugal ☐ Other	
(Use a second sheet if needed)	
18. Elevation:	19. Remarks:
Topography: ☒ Hill ☐ Slope ☐ Upland ☐ Valley	20. Water well contractor's certification: This well was drilled under my jurisdiction and this report is true to the best of my knowledge and belief. Business name <u>Wenger Dilling</u> License No. <u>318</u> Address <u>Colwich</u> Signed <u>Steve Wenger</u> Date <u>2/3/78</u> Authorized representative

Forward the white, blue and pink copies to the Department of Health and Environment

Form WWC-5