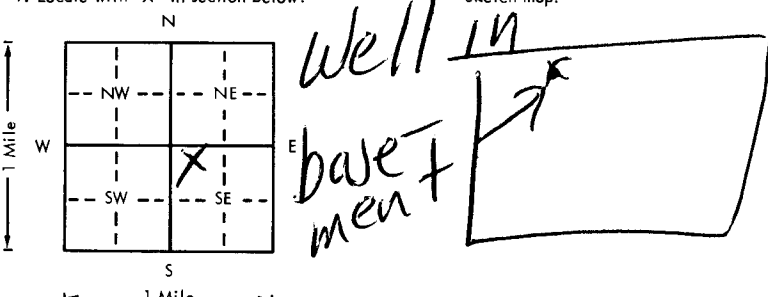


USE TYPEWRITER OR BALL
POINT PEN-PRESS FIRMLY,
PRINT CLEARLY.

WATER WELL RECORD
KSA 82a-1201-1215

Kansas Department of Health and
Environment-Division of Environment
(Water well Contractors)
Topeka, Kansas 66620

1. Location of well:		County	Fraction	Section number	Township number	Range number
		Salisbury	NE NE SE SW	16	T 26 S	R 2 E
2. Distance and direction from nearest town or city: Street address of well location if in city: 103 Centennial Ct. Colwich KS				3. Owner of well: Steve Lee Const R.R. or street: 6110 Bella Rd City, state, zip code: Wichita KS 67204		
4. Locate with "X" in section below: 				6. Bore hole dia. 4 in. Completion date 10/14/79 Well depth 51 ft.		
5. Type and color of material				7. Cable tool Rotary Driven Dug Hollow rod Jetted Bored Reverse rotary		
From To				8. Use: X Domestic Public supply Industry Irrigation Air conditioning Stock Lawn Oil field water Other		
Top soil 0 2				9. Casing: Material Steel strength Above or below Threaded Welded X Surface 12 in. RMP PVC Weight 450 lbs./ft. Dia. 5 in. 51 ft. depth Wall Thickness: inches or Dia. in. to ft. depth gage No. 200		
red clay 2 16				10. Screen: Manufacturer's name PM-MAC Type 200 Dia. 5 in. Slot/gauze 1/16 Length 10 ft. Set between 41 ft. and 51 ft. Gravel pack? Yes size range of material 3/8		
fine to med. sand 16 33				11. Static water level: 17 ft. below land surface Date 10/14/79		
red clay 33 34				12. Pumping level below land surfaces: 18 ft. after 12 hrs. pumping 20 g.p.m. ft. after hrs. pumping g.p.m. Estimated maximum yield 50 g.p.m.		
med. to coarse gravel 34 51				13. Water sample submitted: mo./day/yr. Yes X No Date		
				14. Well head completion: Pitless adapter 12 inches above grade		
				15. Well grouted? Yes With: Neat cement Bentonite X Concrete Depth: From 0 ft. to 16 ft.		
				16. Nearest source of possible contamination: ft. Direction NONE Well disinfected upon completion? X Yes No		
				17. Pump: X Not installed Manufacturer's name Model number HP Volts Length of drop pipe ft. capacity g.p.m. Type: Submersible Turbine Jet Reciprocating Centrifugal Other		
(Use a second sheet if needed)						
18. Elevation:		19. Remarks:		20. Water well contractor's certification: This well was drilled under my jurisdiction and this report is true to the best of my knowledge and belief. Business name: Colwich KS License No. 318 Address: Colwich KS Signed: [Signature] 10/14/79 Authorized representative		

Forward the white, blue and pink copies to the Department of Health and Environment

Form WWC-5