

1 LOCATION OF WATER WELL: County SeDg Fraction SW 1/4 SE 1/4 SE 1/4 Section Number 16 Township Number T 26 S Range Number R 2 E/W

Distance and direction from nearest town or city street address of well if located within city?

2 WATER WELL OWNER:


RR#, St. Address, Box #:

City, State, ZIP Code:

Board of Agriculture, Division of Water Resources

Application Number:

3 LOCATE WELL'S LOCATION WITH AN "X" IN SECTION BOX:

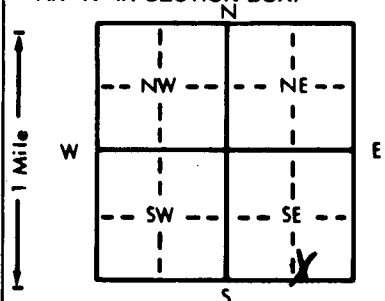

4 DEPTH OF COMPLETED WELL: 50 ft. ELEVATION:

Depth(s) Groundwater Encountered 1. 24 ft. 2. 20 ft. 3. 10-31-85 ft.

WELL'S STATIC WATER LEVEL 24 ft. below land surface measured on mo/day/yr 10-31-85

Pump test data: Well water was 20 ft. after 20 hours pumping gpm

Est. Yield 50 gpm: Well water was 20 ft. after 20 hours pumping gpm

Bore Hole Diameter 11 in. to 50 ft., and 50 in. to 50 ft.

WELL WATER TO BE USED AS: 5 Public water supply 8 Air conditioning 11 Injection well

Domestic 3 Feedlot 6 Oil field water supply 9 Dewatering 12 Other (Specify below)

2 Irrigation 4 Industrial 7 Lawn and garden only 10 Observation well

Was a chemical/bacteriological sample submitted to Department? Yes No; If yes, mo/day/yr sample was submitted

Water Well Disinfected? Yes No

5 TYPE OF BLANK CASING USED:

1 Steel 3 RMP (SR) 5 Wrought iron 8 Concrete tile CASING JOINTS: Glued Clamped

2 PVC 4 ABS 6 Asbestos-Cement 9 Other (specify below) Welded

Blank casing diameter 5 in. to 40 ft., Dia 40 in. to 40 ft., Dia 40 in. to 40 ft.

Casing height above land surface 12 in., weight 159 lbs./ft. Wall thickness or gauge No. SOR-26

TYPE OF SCREEN OR PERFORATION MATERIAL:

1 Steel 3 Stainless steel 5 Fiberglass 7 PVC 10 Asbestos-cement

2 Brass 4 Galvanized steel 6 Concrete tile 8 RMP (SR) 11 Other (specify)

SCREEN OR PERFORATION OPENINGS ARE: 5 Gauzed wrapped 8 Saw cut 11 None (open hole)

1 Continuous slot 3 Mill slot 6 Wire wrapped 9 Drilled holes

2 Louvered shutter 4 Key punched 7 Torch cut 10 Other (specify)

SCREEN-PERFORATED INTERVALS: From 40 ft. to 50 ft., From 40 ft. to 50 ft.

GRAVEL PACK INTERVALS: From 13 ft. to 50 ft., From 13 ft. to 50 ft.

6 GROUT MATERIAL:

1 Neat cement 2 Cement grout 3 Bentonite 4 Other

Grout Intervals: From 3 ft. to 13 ft., From 3 ft. to 13 ft., From 3 ft. to 13 ft.

What is the nearest source of possible contamination:

1 Septic tank 4 Lateral lines 7 Pit privy 10 Livestock pens 14 Abandoned water well

2 Sewer lines 5 Cess pool 8 Sewage lagoon 11 Fuel storage 15 Oil well/Gas well

3 Watertight sewer lines 6 Seepage pit 9 Feedyard 12 Fertilizer storage 16 Other (specify below)

Direction from well? South How many feet? 230

FROM	TO	LITHOLOGIC LOG	FROM	TO	LITHOLOGIC LOG
0	2	top soil			
2	18	Clay			
18	30	fine sand			
30	31	Clay			
31	50	Med Sand			

7 CONTRACTOR'S OR LANDOWNER'S CERTIFICATION: This water well was (1) constructed, (2) reconstructed, or (3) plugged under my jurisdiction and was

completed on (mo/day/year) 10-31-85 and this record is true to the best of my knowledge and belief. Kansas

Water Well Contractor's License No. 3131 This Water Well Record was completed on (mo/day/yr) 10-31-85

under the business name of Wenger Ditch by (signature) Wenger

INSTRUCTIONS: Use typewriter or ball point pen. PLEASE PRESS FIRMLY and PRINT clearly. Please fill in blanks, underline or circle the correct answers. Send top three copies to Kansas

Department of Health and Environment, Office of Oil Field and Environmental Geology, Regulation and Permitting Section, Topeka, Kansas 66620-7500, Telephone: 913-862-9360. Send one

to WATER WELL OWNER and retain one for your records.