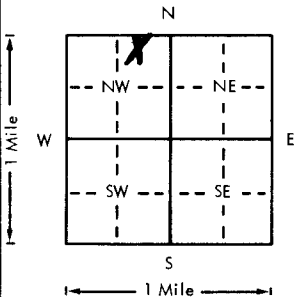
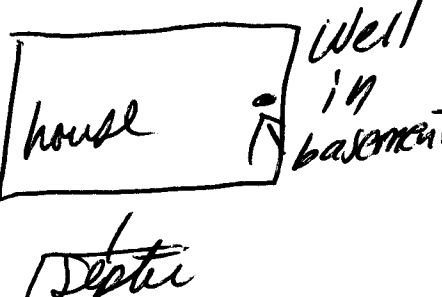


USE TYPEWRITER OR BALL
POINT PEN-PRESS FIRMLY,
PRINT CLEARLY.

WATER WELL RECORD
KSA 82a-1201-1215

Kansas Department of Health and
Environment-Division of Environment
(Water well Contractors)
Topeka, Kansas 66620

1. Location of well: <u>Ledgwick</u>		County: <u>NW 1/4 NE 1/4 NW 1/4</u>		Section number: <u>20</u>		Township number: <u>T 26 S</u>		Range number: <u>R 2 E</u>	
2. Distance and direction from nearest town or city: <u>1 3/4 W. Colwich KS</u>				3. Owner of well: <u>Norbert Wetta</u> R.R. or street: <u>R.R.</u> City, state, zip code: <u>Colwich KS 67030</u>					
4. Locate with "X" in section below: 				Sketch map: 		6. Bore hole dia. <u>11</u> in. Completion date: <u>10/30/78</u> Well depth: <u>50</u> ft.			
5. Type and color of material				From		To		7. ☒ Cable tool ☒ Rotary ☐ Driven ☐ Dug ☐ Hollow rod ☐ Jetted ☐ Bored ☐ Reverse rotary	
Top soil				03				8. Use: ☒ Domestic ☐ Public supply ☐ Industry ☐ Irrigation ☐ Air conditioning ☐ Stock ☐ Lavatory ☐ Oil field water ☐ Other	
red clay.				319		0		9. Casing: Material: <u>Styrene</u> Height: <u>Above</u> or below Threaded ☐ Welded ☒ Surface <u>12</u> in. RMP ☒ PVC ☐ Weight <u>1.50</u> lbs./ft. Dia. <u>5</u> in. <u>50</u> ft. depth Wall Thickness: <u>inches</u> or Dia. <u>in.</u> to <u>ft.</u> depth Gauge No. <u>200</u>	
fine sand				1933				10. Screen: Manufacturer's name: <u>Sunflower</u> Type <u>200</u> Dia. <u>5 1/4</u> Slot gauge <u>1/16</u> Length <u>8 1/2</u> Set between <u>40</u> ft. and <u>48</u> ft. ft. and <u>ft.</u> Gravel pack? <u>yes</u> Size range of material: <u>3/8</u>	
red clay				3334				11. Static water level: <u>21</u> ft. below land surface Date <u>10/20/78</u> <u>23</u> ft. after <u>15</u> hrs. pumping <u>15</u> g.p.m. <u>ft.</u> after <u>hrs.</u> pumping <u>g.p.m.</u> Estimated maximum yield <u>35-55</u> g.p.m.	
med. gravel.				3450				12. Pumping level below and surfaces: 13. Water sample submitted: <u>mo./day/yr.</u> ☐ Yes ☒ No Date <u>10/30/78</u>	
								14. Well head completion: ☐ Pitless adapter <u>12</u> inches above grade	
								15. Well grouted? <u>yes</u> With: ☐ Neat cement ☐ Bentonite ☒ Concrete Depth: From <u>6</u> ft. to <u>16</u> ft.	
								16. Nearest source of possible contamination: <u>90</u> ft. Direction <u>SW</u> Type <u>Septic</u> Well disinfected upon completion? ☒ Yes ☐ No	
								17. Pump: ☒ Not installed Manufacturer's name <u>Wenger</u> Model number <u>318</u> HP <u>1/2</u> Volts <u>115</u> Length of drop pipe <u>10</u> ft. capacity <u>10</u> g.p.m. Type: ☐ Submersible ☐ Turbine ☐ Jet ☐ Reciprocating ☐ Centrifugal ☐ Other	
18. Elevation:				19. Remarks:		20. Water well contractor's certification: This well was drilled under my jurisdiction and this report is true to the best of my knowledge and belief. <u>Wenger</u> <u>318</u> Business name <u>Colwich</u> License No. <u>10/30/78</u> Address <u>Colwich</u> Signed <u>John Wenger</u> Authorized representative Date <u>10/30/78</u>			

Forward the white, blue and pink copies to the Department of Health and Environment

Form WWC-5