USE TYPEWRITER OR BALL POINT PEN-PRESS FIRMLY, PRINT CLEARLY.

WATER WELL RECORD
KSA 82a-1201-1215

Kansas Department of Health and Environment-Division of Environment
(Water well Contractors)
Topeka, Kansas 66620

1. Location of well: County: Sedgwick | Fraction: NE 1/4 NE 1/4 NW 1/4 | Section number: 21 | Township number: T 26 S | Range number: R 2 E (W)

2. Distance and direction from nearest town or city:
Street address of well location if in city: 410 So 8th Colwich Ks

3. Owner of well: Kenneth Jackson
R.R. or street: 856 So Vassar
City, state, zip code: Wichita, Ks 67218

4. Locate with "X" in section below:

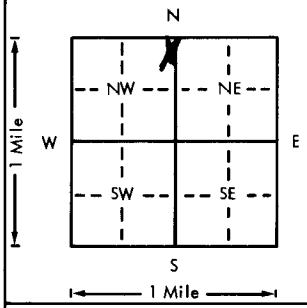

Sketch map:

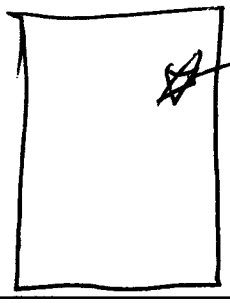

6. Bore hole dia. 11 in. Completed date 4/4/78
Well depth 69 ft.

7. __ Cable tool X Rotary __ Driven __ Dug
__ Hollow rod __ Jetted __ Bored __ Reverse rotary

8. Use: X Domestic __ Public supply __ Industry
__ Irrigation __ Air conditioning __ Stock
__ Lawn __ Oil field water __ Other

9. Casing: Material: Styrene Height: Above or below
Threaded ___ Welded X Surface 12 in.
RMP ___ PVC ___ Weight 1.50 lbs./ft.
Dia. 5 in. to 69 ft. depth Wall Thickness: inches or
Dia. ___ in. to ___ ft. depth gage No. 200

10. Screen: Manufacturer's name Sunflower
Type 200 Dia. 5 in.
Slot/gauze 1/40 Length 5 ft.
Set between 64 ft. and 69 ft.
___ ft. and ___ ft.
Gravel pack? yes Size range of material 3/8

11. Static water level:
18 ft. below land surface Date 4/4/78 mo./day/yr.

12. Pumping level below land surfaces:
24 ft. after 1/2 hrs. pumping 20 g.p.m.
___ ft. after ___ hrs. pumping ___ g.p.m.
Estimated maximum yield 35 g.p.m.

13. Water sample submitted: mo./day/yr.
__ Yes X No Date ___

14. Well head completion:
__ Pitless adapter 12 Inches above grade

15. Well grouted? yes
With: __ Neat cement __ Bentonite X Concrete
Depth: From 6 ft. to 16 ft.

16. Nearest source of possible contamination:
ft. 250 Direction W. Type Creek
Well disinfected upon completion? X Yes __ No

17. Pump: X Not installed
Manufacturer's name ___
Model number ___ HP ___ Volts ___
Length of drop pipe ___ ft. capacity ___ g.p.m.
Type:
__ Submersible __ Turbine
__ Jet __ Reciprocating
__ Centrifugal __ Other

5. Type and color of material

From	To
0	3
3	19
19	31
31	48
48	49
49	54
54	69

Top soil
Red clay
Gray Clay
fine sugar sand
Gray clay
fine sand
medium gravel

(Use a second sheet if needed)

18. Elevation:
Topography:
__ Hill
__ Slope
__ Upland
X Valley

19. Remarks:

20. Water well contractor's certification:
This well was drilled under my jurisdiction and this report is true to the best of my knowledge and belief.
Business name Jennings Drilling License No. 318
Address Colwich Ks
Signed Jennings Authorized representative Date 4/4/78

Sec 21 T 26 S R 2 E (W) 1/4 NE 1/4 NE 1/4 NW 1/4

Forward the white, blue and pink copies to the Department of Health and Environment

Form WWC-5

MI-1023