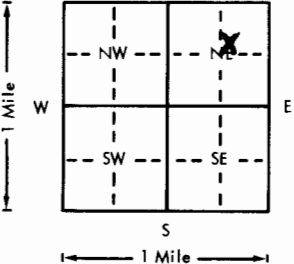
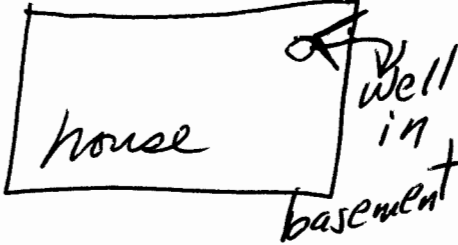


USE TYPEWRITER OR BALL
POINT PEN-PRESS FIRMLY,
PRINT CLEARLY.

WATER WELL RECORD
KSA 82a-1201-1215

Kansas Department of Health and
Environment-Division of Environment
(Water well Contractors)
Topeka, Kansas 66620

1. Location of well:		County <u>Sedg.</u>	Fraction <u>SW 1/4 NE 1/4 NE 1/4</u>	Section number <u>21</u>	Township number <u>T 26 S R 2 E W</u>	Range number
2. Distance and direction from nearest town or city: Street address of well location if in city: <u>530 Homestead Church KS</u>				3. Owner of well: <u>Dan Prichard</u> R.R. or street: <u>208 No. Colby</u> City, state, zip code: <u>Valley Center KS 67147</u>		
4. Locate with "X" in section below:		Sketch map:		6. Bore hole dia. <u>11</u> in. Completion date <u>2/27/78</u> Well depth <u>76</u> ft.		
				7. ☒ Cable tool ☒ Rotary ☐ Driven ☐ Dug ☐ Hollow rod ☐ Jetted ☐ Bored ☐ Reverse rotary		
5. Type and color of material				8. Use: ☒ Domestic ☐ Public supply ☐ Industry ☐ Irrigation ☐ Air conditioning ☐ Stock ☐ Lawn ☐ Oil field water ☐ Other		
				9. Casing: Material <u>PVC</u> Height <u>Above</u> or below Threaded ☐ Welded ☒ Surface <u>12</u> in. RMP ☐ PVC ☒ Weight <u>2.76</u> lbs./ft. Dia. <u>5</u> in. to <u>76</u> ft. depth Wall Thickness: inches or Dia. <u>5</u> in. to <u>76</u> ft. depth gage No. <u>258</u>		
				10. Screen: Manufacturer's name <u>M.P.T.</u> Type <u>Sch 40</u> Dia. <u>5 in</u> Slot/gauze <u>1/16</u> Length <u>5 ft</u> Set between <u>70</u> ft. and <u>760</u> ft. ft. and <u>760</u> ft. Gravel pack? <u>Yes</u> Size range of material <u>3/8</u>		
				11. Static water level: <u> </u> mo./day/yr. <u> </u> ft. below land surface Date <u> </u>		
				12. Pumping level below land surfaces: <u> </u> ft. after <u> </u> hrs. pumping <u> </u> g.p.m. <u> </u> ft. after <u> </u> hrs. pumping <u> </u> g.p.m. Estimated maximum yield <u> </u> g.p.m.		
				13. Water sample submitted: <u> </u> mo./day/yr. <u> </u> Yes ☒ No ☐ Date <u> </u>		
				14. Well head completion: <u> </u> Pitless adapter <u>12</u> inches above grade		
				15. Well grouted? <u>Yes</u> With: <u> </u> Neat cement <u> </u> Bentonite ☒ Concrete Depth: From <u>6</u> ft. to <u>16</u> ft.		
				16. Nearest source of possible contamination: ft. <u> </u> Direction <u>North</u> Type <u> </u> Well disinfected upon completion? ☒ Yes ☐ No		
				17. Pump: ☒ Not installed Manufacturer's name <u> </u> Model number <u> </u> HP <u> </u> Volts <u> </u> Length of drop pipe <u> </u> ft. capacity <u> </u> g.p.m. Type: <u> </u> Submersible <u> </u> Turbine <u> </u> Jet <u> </u> Reciprocating <u> </u> Centrifugal <u> </u> Other		
				(Use a second sheet if needed)		
18. Elevation:		19. Remarks:		20. Water well contractor's certification: This well was drilled under my jurisdiction and this report is true to the best of my knowledge and belief. <u>Weninger Drilling</u> <u>3/8</u> Business name <u>Valley Center KS</u> License No. <u> </u> Address <u> </u> Signed <u>Joel Weninger</u> Date <u>2/27/78</u> Authorized representative		
Topography: ☐ Hill ☐ Slope ☒ Upland ☐ Valley						

Forward the white, blue and pink copies to the Department of Health and Environment

Form WWC-5