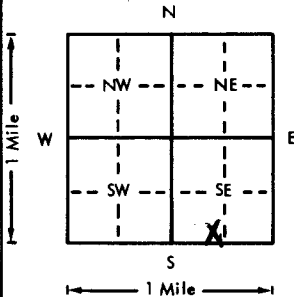
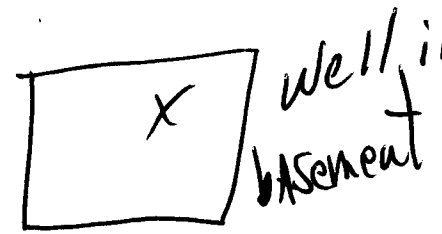


USE TYPEWRITER OR BALL
POINT PEN-PRESS FIRMLY,
PRINT CLEARLY.

WATER WELL RECORD
KSA 82a-1201-1215

Kansas Department of Health and
Environment-Division of Environment
(Water well Contractors)
Topeka, Kansas 66620

1. Location of well:		County <u>Sedg.</u>	Fraction <u>SE 1/4 SW 1/4 SE 1/4</u>	Section number <u>26</u>	Township number <u>T 26 S</u>	Range number <u>R 2 E</u>
2. Distance and direction from nearest town or city: Street address of well location if in city:		<u>2 E 25 1/4 W Colwich KS.</u>		3. Owner of well: <u>Bill Heiser</u> R.R. or street: <u>3901 No. 135th West</u> City, state, zip code: <u>Wichita KS 67223</u>		
4. Locate with "X" in section below:		Sketch map:		6. Bore hole dia. <u>10</u> in. Completion date <u>6/9/77</u> Well depth <u>65</u> ft.		
				7. ☒ Cable tool ☒ Rotary ☐ Driven ☐ Dug ☐ Hollow rod ☐ Jetted ☐ Bored ☐ Reverse rotary		
5. Type and color of material		From		To		8. Use: ☒ Domestic ☐ Public supply ☐ Industry ☐ Irrigation ☐ Air conditioning ☐ Stock ☐ Lawn ☐ Oil field water ☐ Other
<u>Top soil.</u>		<u>0</u>		<u>6</u>		9. Casing: Material <u>PVC</u> Height: <u>Above or below</u> Threaded ☐ Welded ☒ Surface <u>12</u> in. RMP ☐ PVC ☒ Weight <u>231</u> lbs./ft. Dia. <u>5</u> in. to <u>65</u> ft. depth Wall Thickness: <u>inches or</u> Dia. <u>in.</u> to <u>ft.</u> depth gage No. <u>160</u>
<u>red clay.</u>		<u>6</u>		<u>18</u>		10. Screen: Manufacturer's name <u>Pumped</u> <u>MPI</u> Type <u>PVC</u> Dia. <u>5 1/2</u> Slot/gauze <u>1/16</u> Length <u>3 1/2</u> Set between <u>60</u> ft. and <u>60</u> ft. Gravel pack? ☒ Size range of material <u>3/8</u>
<u>fine sand & clay.</u>		<u>18</u>		<u>22</u>		11. Static water level: <u>24</u> ft. below land surface Date <u>6/9/77</u>
<u>fine sand.</u>		<u>22</u>		<u>38</u>		12. Pumping level below land surfaces: <u>25</u> ft. after <u>12</u> hrs. pumping <u>20</u> g.p.m. <u>39</u> ft. after <u>12</u> hrs. pumping <u>20</u> g.p.m. Estimated maximum yield <u>20</u> g.p.m.
<u>black clay</u>		<u>38</u>		<u>39</u>		13. Water sample submitted: <u>Yes</u> ☒ No ☐ Date <u>6/9/77</u>
<u>gravel.</u>		<u>39</u>		<u>65</u>		14. Well head completion: ☐ Pitless adapter <u>12</u> inches above grade
						15. Well grouted? <u>Yes</u> With: <u>Neaf cement</u> ☒ Bentonite ☐ Concrete ☐ Depth: From <u>3</u> ft. to <u>18</u> ft.
						16. Nearest source of possible contamination: ft. <u>None</u> Direction <u>None</u> Type <u>None</u> Well disinfected upon completion? ☒ Yes ☐ No
						17. Pump: ☒ Not installed Manufacturer's name <u>Wenger</u> Model number <u>318</u> HP <u>3</u> Volts <u>115</u> Length of drop pipe <u>3</u> ft. capacity <u>3</u> g.p.m. Type: ☐ Submersible ☐ Turbine ☐ Jet ☐ Reciprocating ☐ Centrifugal ☐ Other

Forward the white, blue and pink copies to the Department of Health and Environment

Form WWC-5