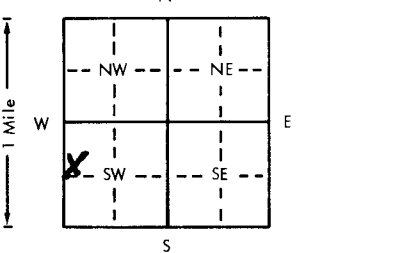


1. Location of well: County <u>Sedgewick</u> Fraction <u>SW 1/4 NW 1/4 SW 1/4</u> Section number <u>27</u> Township number <u>T 26 S</u> Range number <u>R 2 E</u>	
2. Distance and direction from nearest town or city: <u>1 3/4 mile So. Colwich KS.</u> Street address of well location if in city:	
3. Owner of well: <u>Wayne Seimelbauer</u> R.R. or street: <u>#1</u> City, state, zip code: <u>Colwich, KS 67030</u>	
4. Locate with "X" in section below: 	
5. Type and color of material	
6. Bore hole dia. <u>8 1/2</u> in. Completion date: <u>6/28/78</u>	
7. <u>X</u> Cable tool <u>X</u> Rotary <u> </u> Driven <u> </u> Dug <u> </u> Hollow rod <u> </u> Jetted <u> </u> Bored <u> </u> Reverse rotary <u> </u>	
8. Use: <u>X</u> Domestic <u> </u> Public supply <u> </u> Industry <u> </u> Irrigation <u> </u> Air conditioning <u> </u> Stock <u> </u> Lawn <u> </u> Oil field water <u> </u> Other <u> </u>	
9. Casing: Material <u>Steel</u> Height (Above or below) <u>12</u> in. Threaded <u> </u> Welded <u>X</u> Surface <u> </u> RMP <u>X</u> PVC <u> </u> Weight <u>1.50</u> lbs./ft. Dia. <u>5</u> in. to <u>80</u> ft. depth Wall Thickness: inches or Dia. <u> </u> in. to <u> </u> ft. depth Gage No. <u>200</u>	
10. Screen: Manufacturer's name <u>Sunflower</u> Type <u>200</u> Dia. <u>5</u> in. Slot/size <u>1/16</u> Length <u>7 1/2</u> ft. Set between <u>73</u> ft. and <u>80</u> ft. Gravel size range of material <u>3/8</u>	
11. Static water level: <u>16</u> ft. below land surface Date <u>6/28/78</u>	
12. Pumping level below land surfaces: <u>18</u> ft. after <u>12</u> hrs. pumping <u>15</u> g.p.m. <u>18</u> ft. after <u> </u> hrs. pumping <u> </u> g.p.m. Estimated maximum yield <u>35-50</u> g.p.m.	
13. Water sample submitted: <u> </u> Yes <u>X</u> No Date <u> </u>	
14. Well head completion: <u> </u> Pitless adapter <u> </u> <u>12</u> inches above grade	
15. Well grouted? <u>Yes</u> With: <u> </u> Neat cement <u> </u> Bentonite <u>X</u> Concrete Depth: From <u>6</u> ft. to <u>16</u> ft.	
16. Nearest source of possible contamination: <u>8.5</u> ft. Direction <u>East</u> Type <u>Septic</u> Well disinfected upon completion? <u>X</u> Yes <u> </u> No	
17. Pump: <u>X</u> Not installed Manufacturer's name <u> </u> Model number <u> </u> HP <u> </u> Volts <u> </u> Length of drop pipe <u> </u> ft. capacity <u> </u> g.p.m. Type: <u> </u> Submersible <u> </u> Turbine <u> </u> Jet <u> </u> Reciprocating <u> </u> Centrifugal <u> </u> Other <u> </u>	
18. Elevation: Topography: <u>X</u> Hill <u> </u> Slope <u> </u> Upland <u> </u> Valley	
19. Remarks:	
20. Water well contractor's certification: This well was drilled under my jurisdiction and this report is true to the best of my knowledge and belief. <u>Wayne Seimelbauer</u> Business name <u>Colwich</u> License No. <u> </u> Address <u> </u> Date <u>6/28/78</u> Signature <u> </u> Authorized representative	