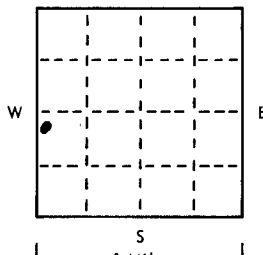
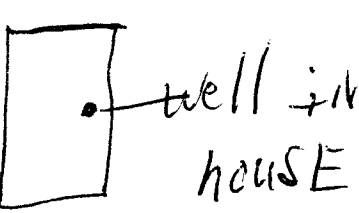


USE TYPEWRITER OR BALL
POINT PEN-PRESS FIRMLY,
PRINT CLEARLY.

WATER WELL RECORD
KSA 82a-1201-1215

T R EW sec 1/4 1/4 1/4 No.

Kansas State Dept. Of Health
(Water Well Contractors)
Forbes-Bldg. 740
Topeka, Kansas 66620

1 Location of well:	County <u>Sedg.</u>	Township name <u>Union</u>	Fraction <u>NW 1/4 SW 1/4</u>	Section number <u>28</u>	Town number <u>26S</u>	Range number <u>2W</u>
Distance and direction from nearest town or city: <u>1 West Colwich KS 1 1/2 South.</u>				3 Owner of well: <u>Mike Fouquet</u> Address: <u>5159 N. 119th West</u> <u>MAIZE KS.</u>		
Locate with "X" in section below: N  W E S 1 Mile		Sketch map:  well in house		4 Well depth: <u>65</u> ft. Date of completion <u>9/14</u> Well diameter <u>5</u> in.		
2 Type and color of material		From		To		5 ☐ Cable tool ☒ Rotary ☐ Driven ☐ Dug ☐ Hollow rod ☐ Jetted ☐ Bored ☐ Reverse rotary
						6 Use: ☒ Domestic ☐ Public supply ☐ Industry ☐ Irrigation ☐ Air conditioning ☐ Commercial ☐ Test well ☐
						7 Casing: Material <u>PPH</u> Height: above/below Threaded ☐ Welded ☐ Surface <u>12</u> in. Diam. <u>5</u> in. to <u>65</u> ft. depth Drive shoe? ☐ Yes ☒ No
						8 Screen: <u>Sunflower</u> Manufacturer <u>plastic</u> Dia. <u>5 1/4</u> Slot/gauze <u>1/8</u> Length <u>10 ft</u> Set between <u>35</u> ft. and <u>65</u> ft. Fittings: <u>3/8</u> Gravel pack ☒ Yes ☐ No Size range of material
						9 Static water level: <u>26</u> ft. below land surface Date <u>9/14</u>
				10 Pumping level below land surfaces: <u>26</u> ft. after <u>1</u> hrs. pumping <u>18</u> g.p.m. <u>26</u> ft. after <u>1</u> hrs. pumping <u>18</u> g.p.m. Estimated maximum yield <u>80</u> g.p.m.		
				11 Water sample submitted: ☐ Yes ☒ No Date <u>9/14</u>		
				12 Well head completion: ☐ Pitless adapter <u>12</u> inches above grade		
				13 Well grouted? ☒ Yes ☐ No ☐ Neat cement ☐ Bentonite ☒ Concrete Depth: From <u>10</u> ft. to <u>20</u> ft.		
				14 Nearest source of possible contamination: ft. <u>None</u> Direction <u>None</u> Type <u>None</u> Well disinfected upon completion? ☒ Yes ☐ No		
				15 Pump: ☐ Not installed Manufacturer's name <u>V.A. 11/1/14</u> Model number <u>11/1/14</u> HP <u>1/2</u> Volts <u>230</u> Length of drop pipe <u>30</u> ft. capacity <u>18</u> g.m.p. Type: ☒ Submersible ☐ Turbine ☐ Jet ☐ Reciprocating ☐ Centrifugal ☐ Other		
16 Remarks: elevation		17 Water well contractor's certification: This well was drilled under my jurisdiction and this report is true, to the best of my knowledge and belief. <u>Weninger Pety 318</u> Business name <u>21 Colwich KS</u> License No. <u>318</u> Address <u>21 Colwich KS</u> Signature <u>Weninger Pety</u> Date <u>9/14</u> Authorized representative				

Forward the white, blue and pink copies to the Kansas State Dept. Of Health.

Form WWC-5