USE TYPEWRITER OR BALL POINT PEN. PRESS FIRMLY. PRINT CLEARLY.

WATER WELL RECORD
KSA 82a-1201-1215

Kansas Department of Health and Environment-Division of Environment
(Water well Contractors)
Topeka, Kansas 66620

1. Location of well:	County	Fraction	Section number	Township number	Range number
	Sedgwick	SW 1/4 NE 1/4 NE 1/4	29	T 26 S	R 2 E (W)

2. Distance and direction from nearest town or city: 1 W. 1 1/4 S. Colwich
Street address of well location if in city:

3. Owner of well: William Strunk
R.R. or street:
City, state, zip code: Colwich, Kansas 67030

4. Locate with "X" in section below:

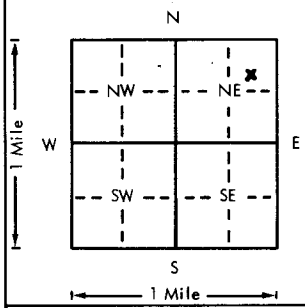

Sketch map:

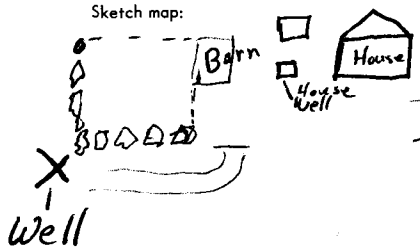

6. Bore hole dia. 30 in. Completion date 2/12/77
Well depth 83 ft.

7. __ Cable tool __ Rotary __ Driven __ Dug
__ Hollow rod __ Jetted __ Bored X Reverse rotary

8. Use: __ Domestic __ Public supply __ Industry
X Irrigation __ Air conditioning __ Stock
__ Lawn __ Oil field water __ Other

9. Casing: Material C-Asb Height: Above or below
Threaded ___ Welded ___ Surface 12 in.
RMP ___ PVC ___ Weight ___ lbs./ft.
Dia. 16 in. to 83 ft. depth Wall Thickness: inches or
Dia. ___ in. to ___ ft. depth gage No. 3/4

5. Type and color of material	From	To
Topsoil	0	1
Fine Sand	1	10
Med. Sand & Clay	10	20
Gravel—med. to good	30	83

(Use a second sheet if needed)

10. Screen: Manufacturer's name Johnson
Type Cem-Asb Dia. 16"
Slot/gauze 1/4 Length 26'
Set between 57 ft. and 83 ft.
___ ft. and ___ ft.
Gravel pack? X Size range of material 3/8

11. Static water level: mo./day/yr.
24 ft. below land surface Date 2/12/77

12. Pumping level below land surfaces:
30 ft. after 1 hrs. pumping 900 g.p.m.
___ ft. after ___ hrs. pumping ___ g.p.m.
Estimated maximum yield ___ g.p.m.

13. Water sample submitted: mo./day/yr.
___ Yes X No Date

14. Well head completion:
___ Pitless adapter 12 Inches above grade

15. Well grouted? X
With: ___ Neat cement ___ Bentonite X Concrete
Depth: From 0 ft. to 10 ft.

16. Nearest source of possible contamination:
ft. 500 Direction E Type Dom.
Well disinfected upon completion? ___ Yes X No

17. Pump: ___ Not installed
Manufacturer's name Peerless
Model number 6890 HP 25 Volts ___
Length of drop pipe 70 ft. capacity 1000 g.p.m.
Type:
___ Submersible X Turbine
___ Jet ___ Reciprocating
___ Centrifugal ___ Other

18. Elevation:

Topography:
___ Hill
___ Slope
X Upland
___ Valley

19. Remarks:

20. Water well contractor's certification:
This well was drilled under my jurisdiction and this report is true to the best of my knowledge and belief.
Business name Weninger Drilling License No. 238
Address Maize
Signed K. Weninger Date 2/
Authorized representative

T 26 R 2 E (W) Sec 29 1/4 SW 1/4 NE 1/4 NE 1/4

Forward the white, blue and pink copies to the Department of Health and Environment

Form WWC-5

MI-1023