

1 LOCATION OF WATER WELLS: Fraction NW 1/4 SW 1/4 SE 1/4 Section Number 36 Township Number T 26 S Range Number R 2 E

County: Sedgewick Distance and direction from nearest town or city street address of well if located within city?

3100 N. 124th West Wichita

2 WATER WELL OWNER: Todd Heberly

RR#, St. Address, Box #:

3100 N. 124th West

Board of Agriculture, Division of Water Resources


City, State, ZIP Code:

Wichita KS 67205

Application Number:

3 LOCATE WELL'S LOCATION WITH AN "X" IN SECTION BOX:

4 DEPTH OF COMPLETED WELL: 60 ft. ELEVATION:

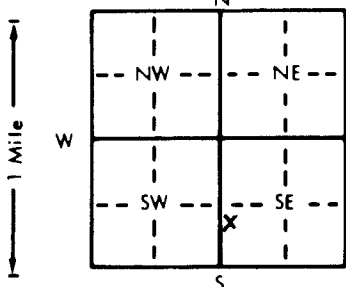

Depth(s) Groundwater Encountered 1. 28 ft. 2. 28 ft. 3. 28 ft.

WELL'S STATIC WATER LEVEL 28 ft. below land surface measured on mo/day/yr 4-14-83

Pump test data: Well water was 30 ft. after 2 hours pumping 20 gpm

Est. Yield 50 gpm: Well water was 30 ft. after 2 hours pumping 20 gpm

Bore Hole Diameter 11 in. to 60 ft., and 60 in. to 60 ft.

WELL WATER TO BE USED AS: 5 Public water supply 8 Air conditioning 11 Injection well

1 Domestic 3 Feedlot 6 Oil field water supply 9 Dewatering 12 Other (Specify below)

2 Irrigation 4 Industrial 7 Lawn and garden only 10 Observation well

Was a chemical/bacteriological sample submitted to Department? Yes X No X; If yes, mo/day/yr sample was submitted

Water Well Disinfected? Yes X No X

5 TYPE OF BLANK CASING USED:

1 Steel 3 RMP (SR) 4 ABS

5 Wrought iron

6 Asbestos-Cement

7 Fiberglass

8 Concrete tile

9 Other (specify below)

CASING JOINTS: Glued X Clamped

Welded

Threaded

Blank casing diameter 5 in. to 50 ft., Dia. 50 in. to 50 ft., Dia. 50 in. to 50 ft.

Casing height above land surface 12 in., weight 1.59 lbs./ft. Wall thickness or gauge No. SDR-26

TYPE OF SCREEN OR PERFORATION MATERIAL:

1 Steel 3 Stainless steel

2 Brass 4 Galvanized steel

5 Fiberglass

6 Concrete tile

7 PVC

8 RMP (SR)

9 ABS

10 Asbestos-cement

11 Other (specify)

12 None used (open hole)

SCREEN OR PERFORATION OPENINGS ARE:

1 Continuous slot 3 Mill slot

2 Louvered shutter 4 Key punched

5 Gauzed wrapped

6 Wire wrapped

7 Torch cut

8 Saw cut

9 Drilled holes

10 Other (specify)

11 None (open hole)

SCREEN-PERFORATED INTERVALS: From 50 ft. to 60 ft., From 50 ft. to 60 ft., From 50 ft. to 60 ft.

GRAVEL PACK INTERVALS: From 13 ft. to 60 ft., From 13 ft. to 60 ft., From 13 ft. to 60 ft.

6 GROUT MATERIAL:

1 Neat cement

2 Cement grout

3 Bentonite

4 Other

Grout Intervals: From 3 ft. to 13 ft., From 3 ft. to 13 ft., From 3 ft. to 13 ft.

What is the nearest source of possible contamination:

1 Septic tank

2 Sewer lines

3 Watertight sewer lines

4 Lateral lines

5 Cess pool

6 Seepage pit

7 Pit privy

8 Sewage lagoon

9 Feedyard

10 Livestock pens

11 Fuel storage

12 Fertilizer storage

13 Insecticide storage

14 Abandoned water well

15 Oil well/Gas well

16 Other (specify below)

Direction from well?

EAST

How many feet? 75

FROM	TO	LITHOLOGIC LOG	FROM	TO	LITHOLOGIC LOG
0	2	Top soil			
2	23	Red clay			
23	32	fine sand			
32	33	red clay			
33	60	med to coarse sand			

7 CONTRACTOR'S OR LANDOWNER'S CERTIFICATION: This water well was (1) constructed, (2) reconstructed, or (3) plugged under my jurisdiction and was completed on (mo/day/year) 4-14-83 and this record is true to the best of my knowledge and belief. Kansas

Water Well Contractor's License No. 318

This Water Well Record was completed on (mo/day/yr) 5-1-83

under the business name of Winnipeg Dilling

by (signature) Winnipeg Dilling

INSTRUCTIONS: Use typewriter or ball point pen. PLEASE PRESS FIRMLY and PRINT clearly. Please fill in blanks, underline or circle the correct answers. Send top three copies to Kansas Department of Health and Environment, Division of Environment, Environmental Geology Section, Topeka, KS 66620. Send one to WATER WELL OWNER and retain one for your records.

OFFICE USE ONLY

T

R

EW

SEC.

36

1/4

SW

1/4

SE

1/4