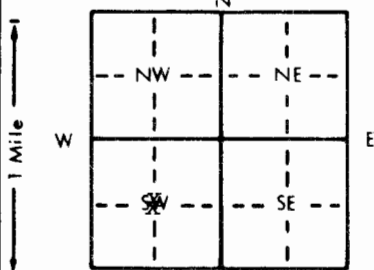


1 LOCATION OF WATER WELL: County: Sedwick	Fraction NW 1/4 SE 1/4 SW 1/4	Section Number 4	Township Number T 26S S	Range Number R 2 E/W
---	---	----------------------------	-----------------------------------	--------------------------------

Distance and direction from nearest town or city street address of well if located within city?

2 Miles North Of Colwich, Kans.

2 WATER WELL OWNER: B.W. Spexarth RR#, St. Address, Box #: 145 So. 6TH ST. City, State, ZIP Code: Colwich, Kans 67030	Board of Agriculture, Division of Water Resources Application Number:
--	--

3 LOCATE WELL'S LOCATION WITH AN "X" IN SECTION BOX: 	4 DEPTH OF COMPLETED WELL ft. ELEVATION: ft. Depth(s) Groundwater Encountered 1. ft. 2. ft. 3. ft. WELL'S STATIC WATER LEVEL ft. below land surface measured on mo/day/yr Pump test data: Well water was ft. after hours pumping gpm Est. Yield gpm: Well water was ft. after hours pumping gpm Bore Hole Diameter in. to ft., and in. to ft. WELL WATER TO BE USED AS: 5 Public water supply 8 Air conditioning 11 Injection well 1 Domestic 3 Feedlot 6 Oil field water supply 9 Dewatering 12 Other (Specify below) XX Irrigation 4 Industrial 7 Lawn and garden only 10 Monitoring well Was a chemical/bacteriological sample submitted to Department? Yes No If yes, mo/day/yr sample was sub- mitted Water Well Disinfected? Yes No
--	--

5 TYPE OF BLANK CASING USED: XX Steel 3 RMP (SR) 2 PVC 4 ABS Blank casing diameter 16" in. to 64" ft., Dia in. to ft., Dia in. to ft. Casing height above land surface in., weight 10 GA lbs./ft. Wall thickness or gauge No. TYPE OF SCREEN OR PERFORATION MATERIAL: 1 Steel 3 Stainless steel 5 Fiberglass 8 RMP (SR) 10 Asbestos-cement 2 Brass 4 Galvanized steel 6 Concrete tile 9 ABS 11 Other (specify) NA 12 None used (open hole) SCREEN OR PERFORATION OPENINGS ARE: 1 Continuous slot 3 Mill slot 5 Gauzed wrapped 8 Saw cut 11 None (open hole) 2 Louvered shutter 4 Key punched 6 Wire wrapped 9 Drilled holes NA 10 Other (specify) SCREEN-PERFORATED INTERVALS: From NA ft. to NA ft., From ft. to ft. From ft. to ft., From ft. to ft. GRAVEL PACK INTERVALS: From ft. to ft., From ft. to ft. From ft. to ft., From ft. to ft.	CASING JOINTS: Glued Clamped Welded Threaded
--	--

6 GROUT MATERIAL: 1 Neat cement 2 Cement grout 3 Bentonite 4 Other Grout Intervals: From 7 ft. to C ft., From ft. to ft., From ft. to ft. What is the nearest source of possible contamination: 1 Septic tank 4 Lateral lines 7 Pit privy 10 Livestock pens 14 Abandoned water well 2 Sewer lines 5 Cess pool 8 Sewage lagoon 11 Fuel storage 15 Oil well/Gas well 3 Watertight sewer lines 6 Seepage pit 9 Feedyard 12 Fertilizer storage 16 Other (specify below) NONE 13 Insecticide storage Direction from well? How many feet?

FROM	TO	LITHOLOGIC LOG	FROM	TO	PLUGGING INTERVALS
			104'	22'	Well gravel.
			22'	7'	3/8 Hole plug Pellets.
			7'	0	Cement.

7 CONTRACTOR'S OR LANDOWNER'S CERTIFICATION: This water well was (1) constructed, (2) reconstructed, or (3) plugged under my jurisdiction and was completed on (mo/day/year) July 23 -94 and this record is true to the best of my knowledge and belief. Kansas Water Well Contractor's License No. 112 This Water Well Record was completed on (mo/day/yr) Aug. 18 -94 under the business name of Wells Drilling Co. by (signature) <i>Neal Wells</i>
--