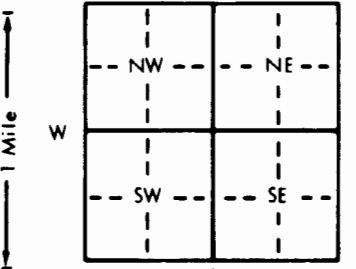


WATER WELL RECORD

Form WWC-5

KSA 82a-1212

PLUGGING REPORT

1 LOCATION OF WATER WELL:		Fraction	Section Number	Township Number	Range Number
County: Sedgwick		NE 1/4 NE 1/4 SE 1/4	11	T 26 S	R 2 EW
Distance and direction from nearest town or city street address of well if located within city?					
2 WATER WELL OWNER: Jerome Schippers					
RR#, St. Address, Box # : Rt.1					
City, State, ZIP Code : Colwich, Kansas 67030					
Board of Agriculture, Division of Water Resources					
Application Number:					
3 LOCATE WELL'S LOCATION WITH AN "X" IN SECTION BOX:		4 DEPTH OF COMPLETED WELL ft. ELEVATION: ft.			
		Depth(s) Groundwater Encountered 1. ft. 2. ft. 3. ft.			
		WELL'S STATIC WATER LEVEL ft. below land surface measured on mo/day/yr			
		Pump test data: Well water was ft. after hours pumping gpm			
		Est. Yield gpm: Well water was ft. after hours pumping gpm			
		Bore Hole Diameter in. to ft., and in. to ft.			
		WELL WATER TO BE USED AS: 5 Public water supply 8 Air conditioning 11 Injection well			
		1 Domestic 3 Feedlot 6 Oil field water supply 9 Dewatering 12 Other (Specify below)			
		X 2 Irrigation 4 Industrial 7 Lawn and garden only 10 Monitoring well			
		Was a chemical/bacteriological sample submitted to Department? Yes No; If yes, mo/day/yr sample was submitted			
		Water Well Disinfected? Yes No			
5 TYPE OF BLANK CASING USED:					
1 Steel		5 Wrought iron	8 Concrete tile	CASING JOINTS: Glued Clamped	
2 PVC		3 RMP (SR)	6 Asbestos-Cement	Welded	
16 4 ABS		7 Fiberglass	9 Other (specify below)	Threaded	
Blank casing diameter in. to ft., Dia in. to ft., Dia in. to ft.					
Casing height above land surface 36 in., weight lbs./ft. Wall thickness or gauge No.					
TYPE OF SCREEN OR PERFORATION MATERIAL:					
1 Steel		3 Stainless steel	5 Fiberglass	7 PVC	10 Asbestos-cement
2 Brass		4 Galvanized steel	6 Concrete tile	8 RMP (SR)	11 Other (specify) NA
				9 ABS	12 None used (open hole)
SCREEN OR PERFORATION OPENINGS ARE:					
1 Continuous slot		3 Mill slot	5 Gauzed wrapped	8 Saw cut	11 None (open hole)
2 Louvered shutter		4 Key punched	6 Wire wrapped	9 Drilled holes	
			7 Torch cut	10 Other (specify) NA	
SCREEN-PERFORATED INTERVALS: From NA ft. to NA ft., From ft. to ft.					
GRAVEL PACK INTERVALS: From ft. to ft., From ft. to ft.					
6 GROUT MATERIAL: 1 Neat cement 2 Cement grout 3 Bentonite 4 Other					
Grout intervals: From 27 ft. to 4 ft., From ft. to ft., From ft. to ft.					
What is the nearest source of possible contamination:					
1 Septic tank		4 Lateral lines	7 Pit privy	10 Livestock pens	14 Abandoned water well
2 Sewer lines		5 Cess pool	8 Sewage lagoon	11 Fuel storage	15 Oil well/Gas well
3 Watertight sewer lines		6 Seepage pit	9 Feedyard	12 Fertilizer storage	16 Other (specify below) NONE
				13 Insecticide storage	
Direction from well? How many feet?					
FROM	TO	LITHOLOGIC LOG	FROM	TO	PLUGGING INTERVALS
60	27	Chlorinated Sand			
27	4	Cement			
4	0	top Soil			
7 CONTRACTOR'S OR LANDOWNER'S CERTIFICATION: This water well was (1) constructed, (2) reconstructed, or (3) plugged under my jurisdiction and was completed on (mo/day/year) 3-11-94 and this record is true to the best of my knowledge and belief. Kansas Water Well Contractor's License No. 134 This Water Well Record was completed on (mo/day/yr) 3-14-94 under the business name of Rosencrantz-Bemis Ent., Inc. by (signature) Doug Dodson					
INSTRUCTIONS: Use typewriter or ball point pen. PLEASE PRESS FIRMLY and PRINT clearly. Please fill in blanks, underline or circle the correct answers. Send top three copies to Kansas Department of Health and Environment, Bureau of Water, Topeka, Kansas 66620-0001. Telephone: 913-296-5545. Send one to WATER WELL OWNER and retain one for your records.					