

1	LOCATION OF WATER WELL:	Fraction	Section Number	Township Number	Range Number
County: <b>Edwards</b>	<b>SW ¼ SW ¼ SE ¼</b>	<b>26</b>	<b>T 26 S</b>	<b>R 20 E/W</b>	

Distance and direction from nearest town or city street address of well if located within city?

9 South, 4 1/8 East of Offerle

2	WATER WELL OWNER:	Jim McClaren
---	-------------------	--------------

RR#, St. Address, Box # : RR2 Box 58


City, State, ZIP Code : Lewis, Ks. 67552

Board of Agriculture, Division of Water Resources

Application Number:

3	LOCATE WELL'S LOCATION WITH	4	DEPTH OF COMPLETED WELL <u>70</u> ft. ELEVATION:
---	-----------------------------	---	--

AN "X" IN SECTION BOX:

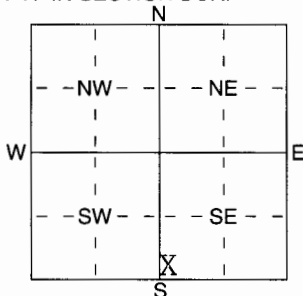

Depth(s) Groundwater Encountered 30.1 ..... ft. 2 ..... ft. 3 12.05 ..... ft.

WELL'S STATIC WATER LEVEL ..... 38 ..... ft. below land surface measured on mo/day/yr ..... 4-12-05

Pump test data: Well water was ..... ft. after ..... hours pumping ..... gpm

Est. Yield N/A gpm: Well water was ..... ft. after ..... hours pumping ..... gpm

WELL WATER TO BE USED AS:    5 Public water supply                      8 Air conditioning                      11 Injection well

1 Domestic	3 Feedlot	6 Oil field water supply	9 Dewatering	12 Other (Specify below)
------------	-----------	--------------------------	--------------	--------------------------

2 Irrigation      4 Industrial      7 Domestic (lawn & garden)      10 Monitoring well ..... Stock .....

Was a chemical/bacteriological sample submitted to Department? Yes ..... No X.....; If yes, mo/day/yr sample was submitted  
Water Well Disinfected? Yes HTH No

5	TYPE OF BLANK CASING USED:
---	----------------------------

1 Steel                      3 RMP (SR)

2 PVC 4 ABS

ank casing diameter \_\_\_\_\_ 5 \_\_\_\_\_ in. to \_\_\_\_\_ 50 \_\_\_\_\_ ft. Dia \_\_\_\_\_ in. to \_\_\_\_\_ ft. Dia \_\_\_\_\_ in. to \_\_\_\_\_ ft.

Casing height above land surface 36 in., weight SDR-26 lbs./ft. Wall thickness or guage No. \_\_\_\_\_

TYPE OF SCREEN OR PERFORATION MATERIAL:


1 Steel	3 Stainless Steel	5 Fiberglass	7 Alum. (extr.)	9 Other (specify) _____
2 Brass	4 Galvanized Steel	6 Concrete tile	8 ABS	10 None used (open hole)


SCREEN OR PERFORATION OPENINGS ARE:

5 Guazed wrapped	8 Saw cut	11 None (open hole)
6 Wire wrapped	9 Drilled holes	

1 Continuous slot	3 Mill slot	6 Wire wrapped	9 Drilled holes	
		7 Torch cut	10 Other (specify)	ft

2 Louvered shutter      4 Key punched      7 Torch cut      10 Other (specify) .....

SCREEN-PERFORATED INTERVALS: From 70 ft. to 50 ft. From \_\_\_\_\_ ft. to \_\_\_\_\_ ft.

From ..... ft. to ..... ft., From ..... ft. to ..... ft.

GRAVEL PACK INTERVALS: From 70 ft. to 20 ft. From \_\_\_\_\_ ft. to \_\_\_\_\_ ft.

From ..... ft. to ..... ft., From ..... ft. to ..... ft.

6	GROUT MATERIAL:	1 Neat cement	2 Cement grout	3 Bentonite	4 Other.....hole plug
---	-----------------	---------------	----------------	-------------	-----------------------

Grout Intervals: From 20 ft. to 0 ft. From \_\_\_\_\_ ft. to \_\_\_\_\_ ft. From \_\_\_\_\_ ft. to \_\_\_\_\_ ft.

What is the nearest source of possible contamination: 10 Livestock pens 14 Abandoned water well


1 Septic tank	4 Lateral lines	7 Pit privy	11 Fuel storage	15 Oil well/Gas well
---------------	-----------------	-------------	-----------------	----------------------

2 Sewer lines                      5 Cess pool                      8 Sewage lagoon                      12 Fertilizer storage                      16 Other (specify below)

3 Watertight sewer lines    6 Seepage pit    9 Feedyard    13 Insecticide storage    .....None.....

Direction from well? \_\_\_\_\_ How many feet? \_\_\_\_\_

Direction from well:			How many feet:		
FROM	TO	LITHOLOGIC LOG	FROM	TO	PLUGGING INTERVALS

[illegible]

7 CONTRACTOR'S OR LANDOWNER'S CERTIFICATION: This water well was (1) constructed, (2) reconstructed, or (3) plugged under my jurisdiction and was completed on (mo/day/year) 4-12-05 and this record is true to the best of my knowledge and belief. Kansas

Water Well Contractor's Licence No. 134 This Water Well Record was completed on (mo/day/yr) 4-18-05

under the business name of Rosencrantz- Bemis by (signature) [Signature]