

**WATER WELL PLUGGING RECORD Form WWC-5P**

KSA 82a-1212 ID NO.

Well #22B


|  |                                     |                            |                                  |  |
|--|-------------------------------------|----------------------------|----------------------------------|--|
| <b>1 LOCATION OF WATER WELL:</b><br>County: <b>Edwards</b> | Fraction<br><b>¼ SE ¼ SE ¼ NE ¼</b> | Section Number<br><b>2</b> | Township Number<br><b>T 26 S</b> | Range Number<br><b>20</b> <input type="checkbox"/> E <input checked="" type="checkbox"/> W |
|--|-------------------------------------|----------------------------|----------------------------------|--|

Street/Rural Address of Well Location; if unknown, distance & direction from nearest town or intersection: If at owner's address, check here  6 1/2 South, 2 1/2 West of Kinsley

**Global Positioning Systems (GPS) information:**  
 Latitude: 37.8172 (in decimal degrees)  
 Longitude: 99.4697 (in decimal degrees)  
 Elevation: \_\_\_\_\_  
 Horizontal Datum:  WGS84,  NAD83,  NAD27  
 Collection Method: \_\_\_\_\_

**2 WATER WELL OWNER:** City of Hays  
 RR#, St. Address, Box #: P.O. Box 56  
 City, State ZIP Code: Hays, KS 67601

GPS unit (Make/Model: \_\_\_\_\_)  
 Digital Map/Photo,  Topographic Map,  Land Survey  
 Est. Accuracy:  < 3 m,  3-5 m,  5-15 m,  > 15 m

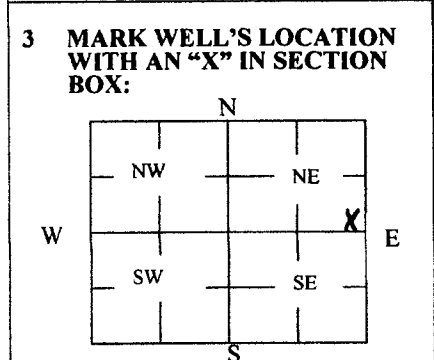

**4 DEPTH OF WELL** 56 ft.  
**WELL'S STATIC WATER LEVEL** 13 ft  
**WELL WAS USED AS:**  
 Domestic Irrigation  Feedlot  Industrial  
 Public Water Supply  Oil Field Water Supply  Domestic (Lawn & Garden)  Air Conditioning  
 Dewatering  Monitoring  Injection Well  Other \_\_\_\_\_  
 Was a chemical/bacteriological sample submitted to Department? Yes  No

**5 TYPE OF BLANK CASING USED:**  
 Steel  PVC  RMP (SR)  ABS  Wrought  Asbestos-Cement  Fiberglass  Concrete Tile  Other (Specify below) \_\_\_\_\_  
 Blank casing diameter 16 in. Was casing pulled? Yes  No  If yes, how much \_\_\_\_\_  
 Casing height above or below land surface 48 in.

**6 GROUT PLUG MATERIAL:**  Neat cement  Cement grout  Bentonite  Other \_\_\_\_\_  
 Grout Plug Intervals: From 13 ft. to 4 ft., From \_\_\_\_\_ ft. to \_\_\_\_\_ ft., From \_\_\_\_\_ ft. to \_\_\_\_\_ ft.  
 What is the nearest source of possible contamination:  
 Septic tank  Sewer lines  Watertight sewer lines  Lateral lines  Cess pool  
 Seepage pit  Pit privy  Sewage lagoon  Feedyard  Livestock pens  
 Fuel storage  Fertilizer storage  Insecticide storage  Abandoned water well  Oil well/Gas well  
 Other (specify below) None  
 Direction from well? \_\_\_\_\_  
 How many feet? \_\_\_\_\_

| FROM | TO | PLUGGING MATERIALS | FROM | TO | PLUGGING MATERIALS |
|------|----|--------------------|------|----|--------------------|
| 56   | 13 | Chlorinated gravel |      |    |                    |
| 13   | 4  | Cement grout       |      |    |                    |
| 4    | 0  | Top soil           |      |    |                    |
|      |    |                    |      |    |                    |
|      |    |                    |      |    |                    |
|      |    |                    |      |    |                    |

**7 CONTRACTOR'S OR LANDOWNER'S CERTIFICATION:** This water well was plugged under my jurisdiction and was completed on (mo/day/year) 2-21-18 and this record is true to the best of my knowledge and belief. Kansas Water Well Contractor's License No. 134. This Water Well Record was completed on (mo/day/year) 2-28-18 under the business name of Rosencrantz- Bemis Ent Inc by (signature) Dora Neefe

Send one white copy to Kansas Department of Health & Environment, Geology Section, 1000 SW Jackson Street, Ste. 420, Topeka, KS 66612-1367. Send one copy to WATER WELL OWNER and retain one for your records.  
 Visit us at <http://www.kdheks.gov/waterwell/index.html> Telephone 785-296-5524.