

USE TYPEWRITER OR BALL POINT PEN-PRESS FIRMLY, PRINT CLEARLY.


WATER WELL RECORD  
KSA 82a-1201-1215

OFTERLE  
SI

Kansas Department of Health and Environment-Division of Environment  
(Water well Contractors)  
Topeka, Kansas 66620

1. Location of well: County FORD Fraction 5 1/4 of NE 1/4 Section number 14 Township number T 26 Range number S R 21 E/W

2. Distance and direction from nearest town or city: 3 E Windthorst  
Street address of well location if in city:  
3. Owner of well: Jenome Fox  
R.R. or street: RR. 1  
City, state, zip code: Kinsley, KANSAS 67547

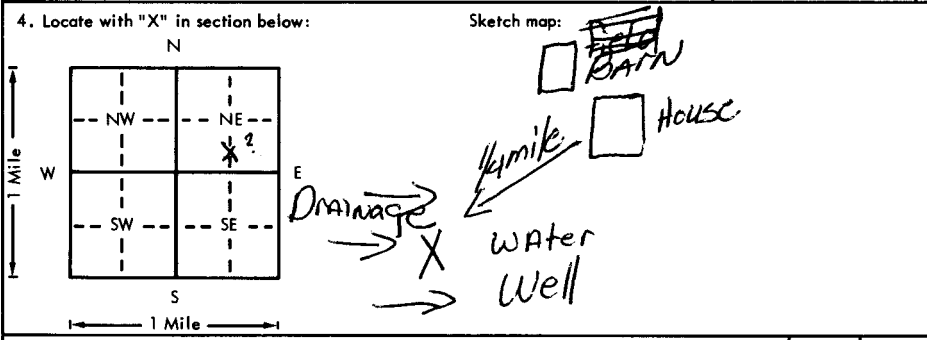

6. Bore hole dia. 2 1/2 in. Completion date \_\_\_\_\_  
Well depth 84 ft.  
7.  Cable tool  Rotary  Driven  Dug  
 Hollow rod  Jetted  Bored  Reverse rotary  
8. Use:  Domestic  Public supply  Industry  
 Irrigation  Air conditioning  Stock  
 Lawn  Oil field water  Other  
9. Casing: Material Steel Height: Above or below  
Threaded \_\_\_\_\_ Welded  Surface 20 in.  
RMP \_\_\_\_\_ PVC \_\_\_\_\_ Weight \_\_\_\_\_ lbs./ft.  
Dia. \_\_\_\_\_ in. to \_\_\_\_\_ ft. depth Wall Thickness: inches or  
Dia. \_\_\_\_\_ in. to \_\_\_\_\_ ft. depth Gage No. 219

5. Type and color of material	From	To
<u>Topsoil</u>	<u>0</u>	<u>2</u>
<u>SAND, fine to coarse, mixed</u>	<u>2</u>	<u>30</u>
<u>Gravel, med. to coarse w/ coarse sand</u>	<u>30</u>	<u>42</u>
<u>Gravel, med. to coarse</u>	<u>42</u>	<u>51</u>
<u>CLAY, grayish brown</u>	<u>51</u>	<u>67</u>
<u>Gravel, med to small w/ fine to coarse SAND</u>	<u>67</u>	<u>72</u>
<u>CLAY, grayish brown</u>	<u>72</u>	<u>78</u>
<u>White Sand Rock</u>	<u>78</u>	<u>84</u>
<u>BROCK 70'</u>		
<u>24</u>		
<u>48' sat thick</u>		
<u>ing</u>		

10. Screen: Manufacturer's name WA BROWN CO  
Type Steel Dia. 1 1/2"  
Slot/gauze \_\_\_\_\_ Length \_\_\_\_\_  
Set between \_\_\_\_\_ ft. and \_\_\_\_\_ ft.  
\_\_\_\_\_ ft. and \_\_\_\_\_ ft.  
Gravel pack?  Size range of material \_\_\_\_\_  
11. Static water level: \_\_\_\_\_ mo./day/yr.  
24 ft. below land surface Date \_\_\_\_\_  
12. Pumping level below land surfaces:  
80 ft. after 1 hrs. pumping 172 g.p.m.  
80 ft. after 2 hrs. pumping 108 g.p.m.  
Estimated maximum yield \_\_\_\_\_ g.p.m.  
13. Water sample submitted: \_\_\_\_\_ mo./day/yr.  
Yes  No  Date \_\_\_\_\_  
14. Well head completion:  
 Pitless adapter \_\_\_\_\_ inches above grade  
15. Well grouted?  YES  
With:  Neat cement  Bentonite  Concrete  
Depth: From 10 ft. to surface  
16. Nearest source of possible contamination:  
ft. \_\_\_\_\_ Direction \_\_\_\_\_ Type \_\_\_\_\_  
Well disinfected upon completion?  Yes  No  
17. Pump:  Not installed  
Manufacturer's name \_\_\_\_\_  
Model number \_\_\_\_\_ HP \_\_\_\_\_ Volts \_\_\_\_\_  
Length of drop pipe \_\_\_\_\_ ft. capacity \_\_\_\_\_ g.p.m.  
Type:  
 Submersible  Turbine  
 Jet  Reciprocating  
 Centrifugal  Other

18. Elevation: \_\_\_\_\_  
19. Remarks: 7070  
Topography:  
 Hill  
 Slope  
 Upland  
 Valley

20. Water well contractor's certification:  
This well was drilled under my jurisdiction and this report is true to the best of my knowledge and belief.  
FWBANK, INC. 334  
Business name 901 South Main license No. \_\_\_\_\_  
Address Fairview, Okla.  
Signed Rodney K. ... Date 7-16  
Authorized representative

T  
R  
E  
W  
E  
14  
1/4  
1/4  
1/4