

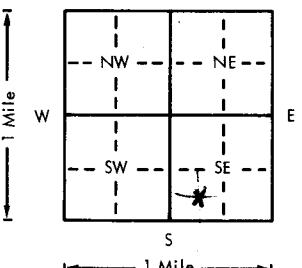
USE TYPEWRITER OR BALL POINT PEN-PRESS FIRMLY, PRINT CLEARLY.

OFFERLE SE

WATER WELL RECORD
KSA 82a-1201-1215

Kansas Department of Health and Environment-Division of Environment (Water well Contractors) Topeka, Kansas 66620

DCD

1. Location of well:		County Ford	Fraction SE 1/4 SW 1/4 SE 1/4	Section number 25	Township number T 26 S	Range number R 21 E
2. Distance and direction from nearest town or city: 2-5 3-E 3-5 34-E of Street address of well location if in city: Windhorst, Ks.				3. Owner of well: Kirk Molitor R.R. or street: none City, state, zip code: Bucklin, Ks. 67834		
4. Locate with "X" in section below: Sketch map: 				6. Bore hole dia. 2 1/2 in. Completion date Well depth 38 ft. 4-3-75		
5. Type and color of material				7. <input checked="" type="checkbox"/> Cable tool <input checked="" type="checkbox"/> Rotary <input type="checkbox"/> Driven <input type="checkbox"/> Dig <input type="checkbox"/> Hollow rod <input type="checkbox"/> Jetted <input type="checkbox"/> Bored <input type="checkbox"/> Reverse rotary		
Top soil				8. Use: <input checked="" type="checkbox"/> Domestic <input type="checkbox"/> Public supply <input type="checkbox"/> Industry <input checked="" type="checkbox"/> Irrigation <input type="checkbox"/> Air conditioning <input type="checkbox"/> Stock <input type="checkbox"/> Lawn <input type="checkbox"/> Oil field water <input type="checkbox"/> Other		
Gravel				9. Casing: Material steel Height: Above or below Threaded <input type="checkbox"/> Welded <input type="checkbox"/> Surface 24 in. RMP <input type="checkbox"/> PVC <input type="checkbox"/> Weight <input type="checkbox"/> lbs./ft. Dia. 1 1/2 in. to 38 ft. depth Wall Thickness: inches or Dia. <input type="checkbox"/> in. to <input type="checkbox"/> ft. depth gage No. 7		
clay				10. Screen: Manufacturer's name Johnson Type steel Dia. <input type="checkbox"/> Slot/gauge 3/16 Length 20 Set between 38 ft. and 18 ft. ft. and <input type="checkbox"/> ft. Gravel pack? <input checked="" type="checkbox"/> Size range of material 1/2 3/4 1 1/2		
Good gravel				11. Static water level: <input type="checkbox"/> mo./day/yr. 7 1/2 ft. below land surface Date 2-28-75		
clay				12. Pumping level below land surfaces: 20 ft. after 1 hrs. pumping 600 g.p.m. <input type="checkbox"/> ft. after <input type="checkbox"/> hrs. pumping <input type="checkbox"/> g.p.m. Estimated maximum yield <input type="checkbox"/> g.p.m.		
Brock 38'				13. Water sample submitted: <input type="checkbox"/> mo./day/yr. <input checked="" type="checkbox"/> Yes <input type="checkbox"/> No Date 2-28-75		
7.5				14. Well head completion: <input type="checkbox"/> Pitless adapter <input type="checkbox"/> Inches above grade		
30.5" sat thick				15. Well grouted? <input checked="" type="checkbox"/> With: <input checked="" type="checkbox"/> Neat cement <input type="checkbox"/> Bentonite <input type="checkbox"/> Concrete Depth: From 0 ft. to 10 ft.		
in of				16. Nearest source of possible contamination: ft. Yam Direction west Type gas well Well disinfected upon completion? <input checked="" type="checkbox"/> Yes <input type="checkbox"/> No		
(Use a second sheet if needed)				17. Pump: Not installed Manufacturer's name W T R Model number 7-100MC HP 30 Volts 440 Length of drop pipe 30 ft. capacity 500 g.p.m. Type: <input type="checkbox"/> Submersible <input checked="" type="checkbox"/> Turbine <input type="checkbox"/> Jet <input type="checkbox"/> Reciprocating <input type="checkbox"/> Centrifugal <input type="checkbox"/> Other		
18. Elevation:	19. Remarks:		20. Water well contractor's certification:			
Topography: <input type="checkbox"/> Hill <input type="checkbox"/> Slope <input checked="" type="checkbox"/> Upland <input type="checkbox"/> Valley	2269 (TOP) 38 2231 v		<input checked="" type="checkbox"/> This well was drilled under my jurisdiction and this report is true to the best of my knowledge and belief. Rosenkrantz-Bemis 134 Business name License No. Address Beat Bend, Ks. 67530 Signed S. K. Moore Date 6-19-79 Authorized representative			

T 26
 R 21 E
 Sec 25
 1/4 C SW SE
 1/4 1/4