

USE TYPEWRITER OR BALL POINT PEN-PRESS FIRMLY, PRINT CLEARLY.

OFFERLE SE


WATER WELL RECORD  
KSA 82a-1201-1215

Kansas Department of Health and Environment-Division of Environment  
(Water well Contractors)  
Topeka, Kansas 66620

BDC

1. Location of well: County Ford Fraction SW 1/4 SE 1/4 NW 1/4 Section number 25 Township number T 26 Range number S R 21 E W

2. Distance and direction from nearest town or city: 1/2 - 5/8 - 5/8 of Windhorst, Ks.  
Street address of well location if in city: 1/2 - 5/8 - 3 - E - 1/4 - 5  
3. Owner of well: Kirk Molitor  
R.R. or street: none  
City, state, zip code: Bucklin, Ks. 67834

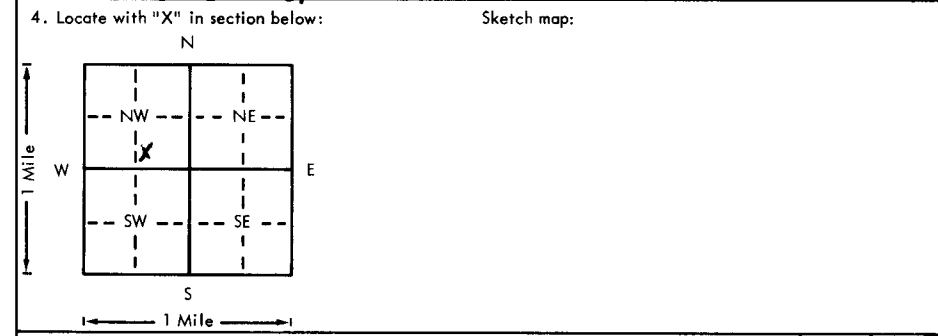

6. Bore hole dia. 3 1/2 in. Completion date 5-21-75  
Well depth 33 1/2 ft.  
7.  Cable tool  Rotary  Driven  Dug  
 Hollow rod  Jetted  Bored  Reverse rotary  
8. Use:  Domestic  Public supply  Industry  
 Irrigation  Air conditioning  Stock  
 Lawn  Oil field water  Other  
9. Casing: Material Steel Height: Above or below  
Threaded  Welded  Surface 18 in.  
RMP PVC Weight          lbs./ft.  
Dia. 16 in. to 33 1/2 ft. depth Wall Thickness: inches or  
Dia.          in. to          ft. depth gage No. 7

5. Type and color of material	From	To
Clay	0	4
Gravel	4	13
Clay	13	16
Sand & gravel	16	33
Clay, Sand & gravel	33	36
Hard	36	40
Brock 33.5		
S.		
28.5 set thick		

10. Screen: Manufacturer's name Johnson  
Type Steel Dia.           
Slot 3/16 Length 10  
Set between 23 1/2 ft. and 33 1/2 ft.  
Gravel pack?  Size range of material 1/2 3/4 1 1 1/2  
11. Static water level: 5 ft. below land surface Date 10-21-74  
12. Pumping level below land surfaces:  
24 ft. after 1 hrs. pumping 200 g.p.m.  
         ft. after          hrs. pumping          g.p.m.  
Estimated maximum yield 300 g.p.m.  
13. Water sample submitted:  Yes  No Date 10-21-74  
14. Well head completion:          Pitless adapter          Inches above grade  
15. Well grouted?   
With:  Neat cement  Bentonite  Concrete  
Depth: From 0 ft. to 10 ft.  
16. Nearest source of possible contamination: 2 mi Direction SW Type gas well  
Well disinfected upon completion?  Yes  No  
17. Pump:  Not installed  
Manufacturer's name Permotor  
Model number 46-51L HP 3 Volts 440  
Length of drop pipe 28 ft. capacity 185 g.p.m.  
Type:  Submersible  Turbine  
 Jet  Reciprocating  
 Centrifugal  Other

18. Elevation: Topography:  Hill  Slope  Upland  Valley  
19. Remarks: 2267 (TOPO)  
33.5  
2233.5

20. Water well contractor's certification:  
This well was drilled under my jurisdiction and this report is true to the best of my knowledge and belief.  
Rosemontz-Bemis 134  
Business name License No.  
Address Great Bend, Ks. 67530  
Signed A. Kelgore Date 6/19/74  
Authorized representative

210 210 210 210 210 210  
 Sec 25 SW 25 NW  
 1/4 1/4 1/4