

USE TYPEWRITER OR BALL POINT PEN—PRESS FIRMLY, PRINT CLEARLY.


WATER WELL RECORD
KSA 82a-1201-1215

BELLE FONT

Kansas Department of Health and Environment—Division of Environment
(Water well Contractors)
Topeka, Kansas 66620

CAA

1. Location of well:	County: Ford	Fraction: NE 1/4 SW 1/4	Section number: 28	Township number: T 26 S	Range number: R 21
2. Distance and direction from nearest town or city: 2 1/2 mi. south of Windhorst Street address of well location if in city:	3. Owner of well: Ivan Kolbeck R.R. or street: Spearville, Ks. 67876 City, state, zip code:				

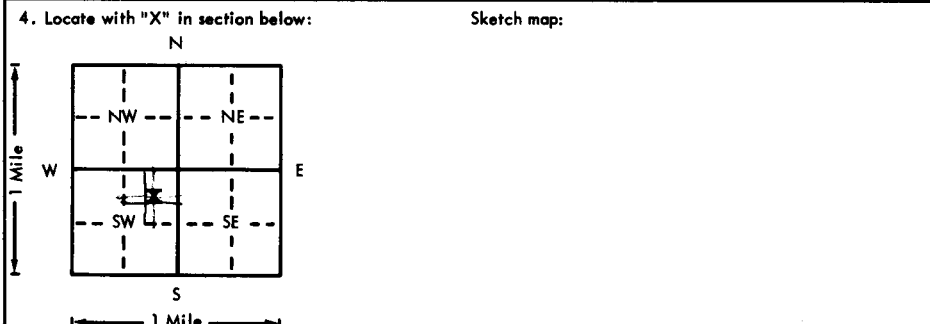

6. Bore hole dia. **26** in. Completion date _____
Well depth **118** ft. **9/18/76**

7. Cable tool Rotary Driven Dug
 Hollow rod Jetted Bored Reverse rotary

8. Use: Domestic Public supply Industry
 Irrigation Air conditioning Stock
 Lawn Oil field water Other

9. Casing: Material **Steel** Height **Above** or below
Threaded _____ Welded Surface **12** in.
RMP _____ PVC _____ Weight **36.86** lbs./ft.
Dia. **16** in. to **118** ft. depth; Wall Thickness: inches or
Dia. _____ in. to _____ ft. depth; gage No **219**

5. Type and color of material	From	To
Clay	0	60
Fine sand, clay balls	60	80
Sand, clay balls	80	100
Sand, gravel, rocks	100	116
Clay and silt	116	118
BR OCK 116' rot & W		
100' S. of top of back		
NOT TO ROCK		

10. Screen: Manufacturer's name **Lakewood**
Type **Millslot** Dia. **16**
Slot/gauze **1/8" x 2** Length **82**
Set between **36** ft. and **118** ft.
Gravel pack? Yes No Size range of material: **2-4**

11. Static water level: **15 1/2** ft. below land surface Date **8/13/76** mo./day/yr.

12. Pumping level below land surfaces:
110 ft. after **24** hrs. pumping **800** g.p.m.
_____ ft. after _____ hrs. pumping _____ g.p.m.
Estimated maximum yield **800** g.p.m.

13. Water sample submitted: _____ mo./day/yr.
Yes No Date _____

14. Well head completion:
 Pitless adapter _____ inches above grade

15. Well grouted? Yes No
With: _____ Neat cement Bentonite Concrete
Depth: From **0** ft. to **10** ft.

16. Nearest source of possible contamination: **NA**
ft. _____ Direction _____ Type _____
Well disinfected upon completion? _____ Yes No

17. Pump: _____ Not installed
Manufacturer's name **Worthington**
Model number **HS-12L-54** HP _____ Volts _____
Length of drop pipe **100** ft. capacity **540** g.p.m.
Type:
 Submersible Turbine
 Jet Reciprocating
 Centrifugal Other

18. Elevation:	19. Remarks: TOPO
----------------	-----------------------------

20. Water well contractor's certification:
This well was drilled under my jurisdiction and this report is true to the best of my knowledge and belief.

High Plains Drilling & Supply, Inc. 136 A
Business name License No. _____
Address **102 N 3rd, Garden City, Ks.**
Signed **Bud Harless** Date **9-7-76**
Authorized representative

296
210
28
1/4 1/4 1/4
C
ME
SU