


1 LOCATION OF WATER WELL: County: Ford	Fraction NE 1/4 NE 1/4 SW 1/4	Section Number 32	Township Number T 26 S	Range Number R 21 E/W
--	---	-----------------------------	----------------------------------	---------------------------------

Distance and direction from nearest town or city street address of well if located within city?
3 south of Windhorst

2 WATER WELL OWNER: **Mr. Tieven Mustang Drilling** **Tieven lease**
 RR#, St. Address, Box #: **Box 1609** Board of Agriculture, Division of Water Resources
 City, State, ZIP Code: **Spearville, Ks. Great Bend, Ks. 67530** Application Number: **T81-772**

3 LOCATE WELL'S LOCATION WITH AN "X" IN SECTION BOX:

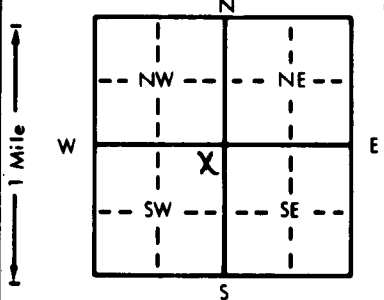

4 DEPTH OF COMPLETED WELL: **180** ft. ELEVATION:

Depth(s) Groundwater Encountered 1. **34** ft. 2. ft. 3. ft.

WELL'S STATIC WATER LEVEL **50** ft. below land surface measured on mo/day/yr **11-15-81**

Pump test data: Well water was ft. after hours pumping gpm

Est. Yield **NA** gpm: Well water was ft. after hours pumping gpm

Bore Hole Diameter **11** in. to **180** ft., and in. to ft.

WELL WATER TO BE USED AS:

5 Public water supply	8 Air conditioning	11 Injection well
1 Domestic	3 Feedlot	6 Oil field water supply
2 Irrigation	4 Industrial	7 Lawn and garden only
		10 Observation well

Was a chemical/bacteriological sample submitted to Department? Yes.....No.....**X**.....; If yes, mo/day/yr sample was submitted

Water Well Disinfected? Yes **HTH** No

5 TYPE OF BLANK CASING USED:

1 Steel	3 RMP (SR)	5 Wrought iron	8 Concrete tile	CASING JOINTS: Glued X Clamped
6 PVC	4 ABS	6 Asbestos-Cement	9 Other (specify below)	Welded
		7 Fiberglass		Threaded

Blank casing diameter **5** in. to **120** ft., Dia in. to ft., Dia in. to ft.

Casing height above land surface **18** in., weight lbs./ft. Wall thickness or gauge No. **258**

TYPE OF SCREEN OR PERFORATION MATERIAL:

1 Steel	3 Stainless steel	5 Fiberglass	8 RMP (SR)	10 Asbestos-cement
2 Brass	4 Galvanized steel	6 Concrete tile	9 ABS	11 Other (specify)
				12 None used (open hole)

SCREEN OR PERFORATION OPENINGS ARE:

1 Continuous slot	3 Mill slot	5 Gauzed wrapped	8 Saw cut	11 None (open hole)
2 Louvered shutter	4 Key punched	6 Wire wrapped	9 Drilled holes	
		7 Torch cut	10 Other (specify)	

SCREEN-PERFORATED INTERVALS: From **120** ft. to **180** ft., From ft. to ft.

GRAVEL PACK INTERVALS: From **10** ft. to **250** ft., From ft. to ft.

6 GROUT MATERIAL: **0** Neat cement 2 Cement grout 3 Bentonite 4 Other

Grout Intervals: From **0** ft. to **10** ft., From ft. to ft., From ft. to ft.

What is the nearest source of possible contamination:

1 Septic tank	4 Lateral lines	7 Pit privy	10 Livestock pens	14 Abandoned water well
2 Sewer lines	5 Cess pool	8 Sewage lagoon	11 Fuel storage	15 Oil well/Gas well
3 Watertight sewer lines	6 Seepage pit	9 Feedyard	12 Fertilizer storage	16 Other (specify below)
			13 Insecticide storage	

Direction from well? **West** How many feet? **75**

FROM	TO	LITHOLOGIC LOG	FROM	TO	LITHOLOGIC LOG
0	25	Clay			
25	75	Clay and shale			
75	120	Shale			
120	145	Sand rock			
145	160	Shale			
160	163	Sand rock			
163	170	Shale			
170	175	Sandy rock			
175	176	Sand rick			
176	225	Shale			
225	230	Sand rock			
230	250	Shale			

7 CONTRACTOR'S OR LANDOWNER'S CERTIFICATION: This water well was (**1** constructed, (2) reconstructed, or (3) plugged under my jurisdiction and was completed on (mo/day/year) **11-15-81** and this record is true to the best of my knowledge and belief. Kansas Water Well Contractor's License No. **134** This Water Well Record was completed on (mo/day/yr) **12-4-81** under the business name of **Rosencrantz-Bemis Ent.** by (signature) **Lora Dodson**

INSTRUCTIONS: Use typewriter or ball point pen, PLEASE PRESS FIRMLY and PRINT clearly. Please fill in blanks, underline or circle the correct answers. Send top three copies to Kansas Department of Health and Environment, Division of Environment, Environmental Geology Section, Topeka, KS 66620. Send one to WATER WELL OWNER and retain one for your records.