


1 LOCATION OF WATER WELL: Fraction near 1/4 C 1/4 NW 1/4 Section Number 36 Township Number T 26 S Range Number R 21 E/W

Distance and direction from nearest town or city street address of well if located within city?  
 2 3/4 south 3 east of Windhorst, Ks.

2 WATER WELL OWNER: Ed Molitor  
 RR#, St. Address, Box #: Rt. 1-Box 38 Board of Agriculture, Division of Water Resources  
 City, State, ZIP Code: Offerle, Ks. 67876 Application Number: 12,327

3 LOCATE WELL'S LOCATION WITH AN "X" IN SECTION BOX:

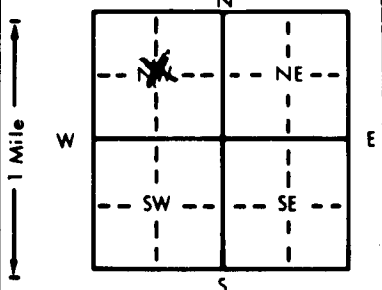

4 DEPTH OF COMPLETED WELL... 37 ft. ELEVATION:

Depth(s) Groundwater Encountered 1. . . . . ft. 2. . . . . ft. 3. . . . . ft.  
 WELL'S STATIC WATER LEVEL . . . 11 . . . . ft. below land surface measured on mo/day/yr . . . 8-5-91 . . . .  
 Pump test data: Well water was . . . . . ft. after . . . . . hours pumping . . . . . gpm  
 Est. Yield . . . . . gpm: Well water was . . . . . ft. after . . . . . hours pumping . . . . . gpm  
 Bore Hole Diameter . . . 26 . . . in. to . . . 37 . . . ft., and . . . . . in. to . . . . . ft.  
 WELL WATER TO BE USED AS:  
 1 Domestic 3 Feedlot 6 Oil field water supply 9 Dewatering 12 Other (Specify below)  
 2 Irrigation 4 Industrial 7 Lawn and garden only 10 Monitoring well  
 Was a chemical/bacteriological sample submitted to Department? Yes . . . . . No. X . . . . .; If yes, mo/day/yr sample was sub-  
 mitted Water Well Disinfected? Yes hth No

5 TYPE OF BLANK CASING USED: 5 Wrought iron 8 Concrete tile CASING JOINTS: Glued . X . . . Clamped . . . . .  
 1 Steel 3 RMP (SR) 6 Asbestos-Cement 9 Other (specify below) Welded . . . . .  
 2 PVC 4 ABS 7 Fiberglass Threaded . . . . .

Blank casing diameter . . . 16 . . . in. to . . . ~~22~~ 14 . . . ft., Dia . . . 16 . . . in. to 28 . . . to 37 ft., Dia . . . in. to . . . ft.  
 Casing height above land surface . . . 12 . . . in., weight SDR 32.5 . . . lbs./ft. Wall thickness or gauge No. . . . .

TYPE OF SCREEN OR PERFORATION MATERIAL:  
 1 Steel 3 Stainless steel 5 Fiberglass 7 PVC 10 Asbestos-cement  
 2 Brass 4 Galvanized steel 6 Concrete tile 8 RMP (SR) 11 Other (specify) . . . . .  
 SCREEN OR PERFORATION OPENINGS ARE:  
 1 Continuous slot 3 Mill slot 5 Gauzed wrapped 8 Saw cut 11 None (open hole)  
 2 Louvered shutter 4 Key punched 7 Torch cut 9 Drilled holes 10 Other (specify) . . . . .

SCREEN-PERFORATED INTERVALS: From . . . 14 . . . ft. to . . . 28 . . . ft., From . . . . . ft. to . . . . . ft.  
 From . . . . . ft. to . . . . . ft., From . . . . . ft. to . . . . . ft.  
 GRAVEL PACK INTERVALS: From . . . 11 . . . ft. to . . . 37 . . . ft., From . . . . . ft. to . . . . . ft.  
 From . . . . . ft. to . . . . . ft., From . . . . . ft. to . . . . . ft.

6 GROUT MATERIAL: 1 Neat cement 2 Cement grout 3 Bentonite 4 Other . . . hole plug . . . . .  
 Grout Intervals: From . . . 0 . . . ft. to . . . 11 . . . ft., From . . . . . ft. to . . . . . ft., From . . . . . ft. to . . . . . ft.

What is the nearest source of possible contamination:  
 1 Septic tank 4 Lateral lines 7 Pit privy 10 Livestock pens 14 Abandoned water well  
 2 Sewer lines 5 Cess pool 8 Sewage lagoon 11 Fuel storage 15 Oil well/Gas well  
 3 Watertight sewer lines 6 Seepage pit 9 Feedyard 12 Fertilizer storage 16 Other (specify below)  
 13 Insecticide storage 14 Irrigation well . . . . .

Direction from well? south How many feet? 15

FROM	TO	LITHOLOGIC LOG	FROM	TO	PLUGGING INTERVALS
0	3	Top soil			
3	23	Sand and gravel clean coarse loose			
23	25	Brown & white clay and rock			
25	33	Sandy brown white clay & white rock			
33	37	Gray clay			

7 CONTRACTOR'S OR LANDOWNER'S CERTIFICATION: This water well was (1) constructed, (2) reconstructed, or (3) plugged under my jurisdiction and was completed on (mo/day/year) . . . 8-6-91 . . . . . and this record is true to the best of my knowledge and belief. Kansas Water Well Contractor's License No. . . . 134 . . . . . This Water Well Record was completed on (mo/day/yr) . . . 8-14-91 . . . . . under the business name of Rosencrantz-Bemis by (signature) Gredia Dodson

INSTRUCTIONS: Use typewriter or ball point pen. PLEASE PRESS FIRMLY and PRINT clearly. Please fill in blanks, underline or circle the correct answers. Send top three copies to Kansas Department of Health and Environment, Bureau of Water, Topeka, Kansas 66620-0001. Telephone: 913-296-5545. Send one to WATER WELL OWNER and retain one for your records.