


1 LOCATION OF WATER WELL: Fraction Section Number Township Number Range Number
 COUNTY: FORD SE 1/4 SE 1/4 NE 1/4 13 T 26 S R 21 W

Distance and direction from nearest town or city street address of well if located within city?
 FROM OFFERLE - ON FORD-EDWARDS CO. LINE - 6 1/2 M SOUTH

2 WATER WELL OWNER: WILLIAMS, DON TRUST
 RR#, St. Address, Box #: 10826 134 ROAD Board of Agriculture, Division of Water Resources
 City, State, ZIP code: OFFERLE, KS 67563- Application Number:

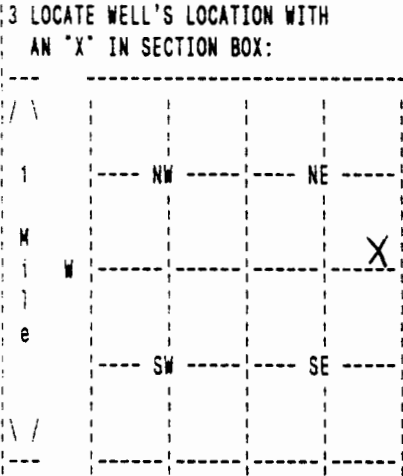

4 DEPTH OF COMPLETED WELL 224 ELEVATION: 0
 Depth(s) Groundwater Encountered 1. 0 ft. 2. 0 ft. 3. 0 ft.
 WELL'S STATIC WATER LEVEL 13 ft. below land surface measured on mo/day/yr 03/23/07
 Pump testdata: Well water was 0 ft. after 0 hours pumping 0 gpm
 Estimated Yield 40 gpm: Well water was 0 ft. after 0 hours pumping 0 gpm
 Bore Hole Diameter 9 in. to 224 ft., and in. to 0 ft.
 WELL WATER TO BE USED AS: DOMESTIC
 Was a chemical/bacteriological sample submitted to department? No ;
 If yes, mo/day/yr sample was submitted Water well disinfected? Yes

5 TYPE OF BLANK CASING USED: CERTA LOC CASIN CASING JOINTS: CLAMPED
 Blank casing diameter 5 in. to 224 ft., Dia in. to 0 ft., Dia in. to 0 ft.
 Casing height above land surface 12 in., weight 200 lbs/ft. Wall thickness or gauge No. 21
 TYPE OF SCREEN OR PERFORATION MATERIAL: PVC
 SCREEN OR PERFORATION OPENINGS ARE: SAW CUT

SCREEN PERFORATED INTERVALS: From 40 ft. to 60 ft., From 200 ft. to 220 ft.
 From 100 ft. to 120 ft., From 0 ft. to 0 ft.
 GRAVEL PACK INTERVALS: From 20 ft. to 224 ft., From 0 ft. to 0 ft.
 From 0 ft. to 0 ft., From 0 ft. to 0 ft.

6 GROUT MATERIAL BENTONITE
 Grout Intervals: From 0 ft. to 20 ft., From 0 ft. to 0 ft., From 0 ft. to 0 ft.
 What is the nearest source of possible contamination: NONE
 Direction from well? How many feet? 0

FROM	TO	LITHOLOGIC LOG	FROM	TO	PLUGGING INTERVALS
0	20	01 TOPSOIL 05 CLAY 37 FIN-COAR SAN			
20	50	37 FIN-COAR SAN			
50	80	16 GRAY CLAY			
80	100	16 GRAY CLAY 27 ROCK			
100	120	27 ROCK 32 TAN CLAY			
120	140	16 GRAY CLAY			
140	160	16 GRAY CLAY 29 SANDSTONE			
160	225	29 SANDSTONE			

7 CONTRACTOR'S OR LANDOWNER'S CERTIFICATION: This water well was Constructed under my jurisdiction and was completed on (mo/day/year) 03/23/07 and this record is true to the best of my knowledge and belief. Kansas Water Well Contractor's License No. 179 This Water Well Record was completed on (mo/day/yr) 03/28/07 under the business name of JOE'S WELL SERVICE, INC. by (signature) *Justin Cisk*