


1 LOCATION OF WATER WELL: Fraction NW 1/4 NW 1/4 NW 1/4 Section Number 22 Township Number T 26 S 5 Range Number R 21 E
 COUNTY: FORD

Distance and direction from nearest town or city street address of well if located within city?
 FROM WINDHORST, KS. - 1/2 SOUTH AND 1 MILE EAST

2 WATER WELL OWNER: ZION LUTHERAN CHURCH
 RR#, St. Address, Box #: R.R. #1 -- BOX 22 Board of Agriculture, Division of Water Resources
 City, State, ZIP code: OPPERLE, KS 67563- Application Number:

3 LOCATE WELL'S LOCATION WITH AN "X" IN SECTION BOX: 4 DEPTH OF COMPLETED WELL 225 ELEVATION: 0
 Depth(s) Groundwater Encountered 1. 0 ft. 2. 0 ft. 3. 0 ft.

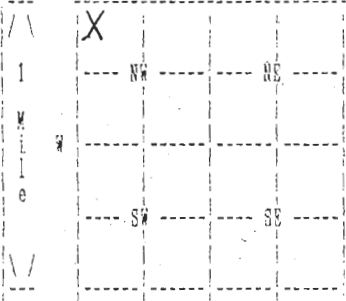

WELL'S STATIC WATER LEVEL 38 ft. below land surface measured on no/day/yr 11/30/94
 Pump test data: Well water was 0 ft. after 0 hours pumping 0 gpm

Estimated Yield 30 gpm: Well water was 0 ft. after 0 hours pumping 0 gpm

5 Bore Hole Diameter 9 in. to 225 ft., and in. to 0 ft.

WELL WATER TO BE USED AS: DOMESTIC

Was a chemical/bacteriological sample submitted to department? No
 If yes, no/day/yr sample was submitted Water well disinfected? Yes

5 TYPE OF BLANK CASING USED: PVC CASING JOINTS: GLOUED
 Blank casing diameter 5 in. to 225 ft., Dia in. to 0 ft., Dia in. to 0 ft.
 Casing height above land surface 12 in., weight 200 lbs/ft. Wall thickness or gauge No. 21
 TYPE OF SCREEN OR PERFORATION MATERIAL: PVC
 SCREEN OR PERFORATION OPENINGS ARE: SAW CUT

SCREEN PERFORATED INTERVALS: From 200 ft. to 220 ft., From 0 ft. to 0 ft.
 From 0 ft. to 0 ft., From 0 ft. to 0 ft.
 GRAVEL PACK INTERVALS: From 40 ft. to 225 ft., From 0 ft. to 0 ft.
 From 0 ft. to 0 ft., From 0 ft. to 0 ft.

6 GROUT MATERIAL BENTONITE
 Grout intervals: From 4 ft. to 40 ft., From 0 ft. to 0 ft., From 0 ft. to 0 ft.
 What is the nearest source of possible contamination: ABANDONED WELL
 Direction from well? SOUTHWEST How many feet? 75

FROM	TO	LITHOLOGIC LOG	FROM	TO	PLUGGING INTERVALS
0	10	TOPSOIL SANDY BROWN CLAY			
10	31	CALACHIE CLAY			
31	53	YELLOW CLAY BROWN CLAY			
53	58	CLAY SANDSTONE			
58	62	YELLOW CLAY			
62	70	CLAY			
70	71	ROCK			
71	78	GRAY SANDSTONE SHALE			
78	85	GRAY SHALE			
85	95	SANDSTONE			

7 CONTRACTOR'S OR LANDOWNER'S CERTIFICATION: This water well was constructed under my jurisdiction and was completed on (no/day/year) 11/30/94 and this record is true to the best of my knowledge and belief. Kansas Water Well Contractor's License No. 179 This Water Well Record was completed on (no/day/yr) 12/20/94 under the business name of JOE'S WELL SERVICE, INC. by signature: *Joel Cuit*

(Continued) WATER WELL RECORD Form WWC-5 KSA 82a-1812

1 LOCATION OF WATER WELL: Fraction NW 1/4 NW 1/4 NW 1/4 Section Number 22 Township Number T 26 S 5 Range Number R 21 E
 COUNTY: FORD

2 WATER WELL OWNER: ZION LUTHERAN CHURCH
 RR#, St. Address, Box #: R.R. #1 -- BOX 22 Board of Agriculture, Division of Water Resources
 City, State, ZIP code: OPPERLE, KS 67563- Application Number:

FROM	TO	LITHOLOGIC LOG
95	120	GRAY SHALE SANDSTONE
120	135	GRAY SANDSTONE
135	180	SANDSTONE CLAY
180	220	TAN IN COLOR SANDSTONE
220	240	RED BED GRAY SHALE