


1 LOCATION OF WATER WELL: County: Ford Fraction: SE 1/4 SE 1/4 SE 1/4 Section Number: 29 Township Number: T 26 S Range Number: R 22 E(W)

Distance and direction from nearest town or city street address of well if located within city?  
From Spearville, 1 mile south, 1/2 mile east, then 5 miles south

2 WATER WELL OWNER: Larry Tasset  
 RR#, St. Address, Box #: 11091 126 Rd.  
 City, State, ZIP Code: Spearville, KS. 67876  
 Board of Agriculture, Division of Water Resources  
 Application Number:

3 LOCATE WELL'S LOCATION WITH AN "X" IN SECTION BOX:

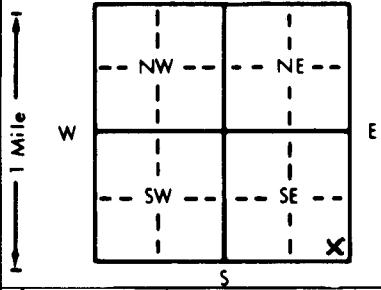

4 DEPTH OF COMPLETED WELL: 65' ft. ELEVATION:

Depth(s) Groundwater Encountered 1. .... ft. 2. .... ft. 3. .... ft.  
 WELL'S STATIC WATER LEVEL: 1.7' ft. below land surface measured on mo/day/yr 10-5-96  
 Pump test data: Well water was .... ft. after .... hours pumping .... gpm  
 Est. Yield .... gpm: Well water was .... ft. after .... hours pumping .... gpm  
 Bore Hole Diameter: 9 7/8 in. to .... ft., and .... in. to .... ft.  
 WELL WATER TO BE USED AS:  
 1 Domestic     3 Feedlot     6 Oil field water supply     9 Dewatering     12 Other (Specify below)  
 2 Irrigation     4 Industrial     7 Lawn and garden only     10 Monitoring well  
 Was a chemical/bacteriological sample submitted to Department? Yes.....No. ; If yes, mo/day/yr sample was submitted  
 Water Well Disinfected? Yes  No

5 TYPE OF BLANK CASING USED: 1 Steel    3 RMP (SR)    5 Wrought iron    8 Concrete tile    CASING JOINTS: Glued  Clamped .....

PVC    4 ABS    6 Asbestos-Cement    9 Other (specify below)    Welded .....

Blank casing diameter: 5" in. to 55' ft., Dia. .... in. to .... ft., Dia. .... in. to .... ft.  
 Casing height above land surface: 12" in., weight 200# lbs./ft. Wall thickness or gauge No. SOR 21

TYPE OF SCREEN OR PERFORATION MATERIAL:  
 1 Steel    3 Stainless steel    5 Fiberglass    8 RMP (SR)    10 Asbestos-cement  
 2 Brass    4 Galvanized steel    6 Concrete tile    9 ABS    11 Other (specify) .....

SCREEN OR PERFORATION OPENINGS ARE:  
 1 Continuous slot    3 Mill slot    5 Gauzed wrapped     8 Saw cut    11 None (open hole)  
 2 Louvered shutter    4 Key punched    6 Wire wrapped    9 Drilled holes

SCREEN-PERFORATED INTERVALS: From 55' ft. to 65' ft., From .... ft. to .... ft.  
 GRAVEL PACK INTERVALS: From 24' ft. to 65' ft., From .... ft. to .... ft.

6 GROUT MATERIAL: 1 Neat cement    2 Cement grout     3 Bentonite    4 Other .....

Grout intervals: From 4' ft. to 24' ft., From .... ft. to .... ft., From .... ft. to .... ft.  
 What is the nearest source of possible contamination:  
 1 Septic tank    4 Lateral lines    7 Pit privy     10 Livestock pens    14 Abandoned water well  
 2 Sewer lines    5 Cess pool    8 Sewage lagoon    11 Fuel storage    15 Oil well/Gas well  
 3 Watertight sewer lines    6 Seepage pit    9 Feedyard    12 Fertilizer storage    16 Other (specify below)  
 13 Insecticide storage .....

Direction from well? west How many feet? 200

FROM	TO	LITHOLOGIC LOG	FROM	TO	PLUGGING INTERVALS
0	1	Topsoil			
1	4	Brown clay			
4	28	Brown clay + caliche			
28	60	Brown sandy clay			
60	62	Med. sand			
62	65	limestone + shales			

7 CONTRACTOR'S OR LANDOWNER'S CERTIFICATION: This water well was  (1) constructed,  (2) reconstructed, or  (3) plugged under my jurisdiction and was completed on (mo/day/year) 10-5-96 and this record is true to the best of my knowledge and belief. Kansas Water Well Contractor's License No. 533 This Water Well Record was completed on (mo/day/yr) 11-5-96 under the business name of Jantzen Water Well Repair by (signature) [Signature]