SPEARVILLE

USE TYPEWRITER OR BALL POINT PEN-PRESS FIRMLY, PRINT CLEARLY.

T R EW sec 1/4 1/4 1/4 No.

WATER WELL RECORD
KSA 82a-1201-1215

Kansas State Dept. Of Health
(Water Well Contractors)
Forbes-Bldg. 740
Topeka, Kansas 66620

1 Location of well:	County	Township name	Fraction	Section number	Town number	Range number
	Ford	Spearville	SW¼	8	26	R22W

Distance and direction from nearest town or city:
2½ mi south of Spearville, Ks.
Street address of well location if in city:

3 Owner of well:
American Products
Address: Spearville, Ks. 67876

Locate with "X" in section below:

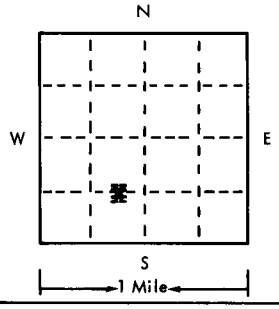

Sketch map:

Cneter of eastside of quarter and 500 ft west.

4 Well depth: 401 ft. Date of completion 8-19-75
Well diameter 26 in.

5 ☐ Cable tool ☒ Rotary ☐ Driven ☐ Dug
☐ Hollow rod ☐ Jetted ☐ Bored ☐ Reverse rotary

6 Use: ☐ Domestic ☐ Public supply ☐ Industry
☒ Irrigation ☐ Air conditioning ☐ Commercial
☐ Test well ☐

7 Casing: Material Steel Height: ~~above~~/below
Threaded ☐ Welded ☒ Surface 12 in.
Diam. 16" Weight 219 lbs./ft.
0 in. to 401 ft. depth Drive shoe? ☐ Yes ☒ No
___ in. to ___ ft. depth

8 Screen:
Manufacturer Lakewood
Type Millslot Dia. 16"
Slot/gauze 1/8 Length 4"
Set between 140 ft. and 220 ft.
Fittings: 381 401 ¼x5/8k
Gravel pack ☒ Yes ☐ No Size range of material

9 Static water level:
166 ft. below land surface Date 8-19-75

10 Pumping level below land surfaces:
390 ft. after 5 hrs. pumping 450 g.p.m.
___ ft. after ___ hrs. pumping ___ g.p.m.
Estimated maximum yield 450 g.p.m.

11 Water sample submitted:
☐ Yes ☒ No Date

12 Well head completion:
☐ Pitless adapter ☒ Inches above grade

13 Well grouted? ☒ Yes ☐ No
☐ Neat cement ☐ Bentonite ☐
Depth: From 0 ft. to 10 ft.

14 Nearest source of possible contamination: NA
ft. ___ Direction ___ Type ___
Well disinfected upon completion? ☐ Yes ☐ No

15 Pump: ☒ Not installed
Manufacturer's name
Model number ___ HP ___ Volts ___
Length of drop pipe ___ ft. capacity ___ g.m.p.
Type:
☐ Submersible ☐ Turbine
☐ Jet ☐ Reciprocating
☐ Certrifugal ☐ Other

2 Type and color of material	From	To
Clay	0	120
Sand	120	220
Clay	220	300
Sand	300	340
Clay, sand	340	400
BROCK ?		
Installation of a pump delayed till later by owners.		

(use a second sheet if needed)

16 Remarks: elevation

Topography:
☐ Hill
☐ Slope
☒ Upland Level TOPO
☐ Valley

2433

17 Water well contractor's certification:
This well was drilled under my jurisdiction and this report is true to the best of my knowledge and belief.
High Plains Drilling & Supply, Inc. 136
Business name License No.
Address 402 N 3rd, Garden City, Ks.
Signed [illegible] Date 9-3-75
Authorized representative

Forward the white, blue and pink copies to the Kansas State Dept. Of Health.

Form WWC-5