

USE TYPEWRITER OR BALL POINT PEN-PRESS FIRMLY, PRINT CLEARLY.

BELLEFONT

Page 1  
WATER WELL RECORD  
KSA 82a-1201-1215


DCC

T R EW sec 1/4 1/4 1/4 No.

Kansas State Dept. Of Health  
(Water Well Contractors)  
Forbes-Bldg. 740  
Topeka, Kansas 66620

1 Location of well: County **Ford** Township name **Spearville sw sw sE** Fraction **20** Section number **T26S** Town number **R22W** Range number

Distance and direction from nearest town or city: **6 miles south of Spearville**  
Street address of well location (if in city):  
3 Owner of well: **Art Shean**  
Address: **Spearville, Kansas**

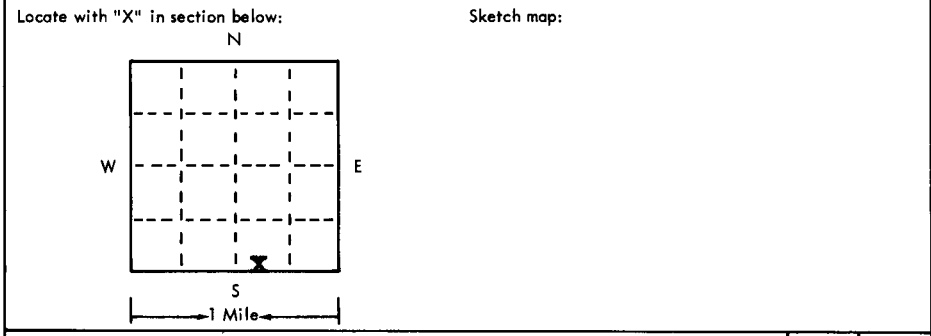

4 Well depth: **336** ft. Date of completion **8-18-75**  
Well diameter **8** in.

5  Cable tool  Rotary  Driven  Dug  
 Hollow rod  Jetted  Bored  Reverse rotary

6 Use:  Domestic  Public supply  Industry  
 Irrigation  Air conditioning  Commercial  
 Test well

7 Casing: Material **plastic** Height: above/below  
Threaded  Welded  Surface **12** in.  
Diam. \_\_\_\_\_ Weight **1.8** lbs./ft. \_\_\_\_\_  
**5** in. to **336** ft. depth Drive shoe?  Yes  No  
\_\_\_\_\_ in. to \_\_\_\_\_ ft. depth!

2	Type and color of material	From	To
	<del>Dark Gray</del>	<del>0</del>	<del>7</del>
	<del>Yellow and gray clay</del>	<del>7</del>	<del>60</del>
	<del>Blue shale</del>	<del>60</del>	<del>73</del>
	<del>Hard Rock</del>	<del>73</del>	<del>74</del>
	<del>Blue shale</del>	<del>74</del>	<del>92</del>
	<del>Dark gray shale</del>	<del>92</del>	<del>111</del>
	<del>Blue mucky shale with 20% sand stone</del>	<del>111</del>	<del>120</del>
	<del>Light sandy gray shale</del>	<del>120</del>	<del>140</del>
	<del>Gray shale with sand stone streaks</del>	<del>140</del>	<del>155</del>
	<del>Brown sand stone</del>	<del>155</del>	<del>162</del>
	<del>Light gray shale</del>	<del>162</del>	<del>172</del>
	<del>Dark gray shale</del>	<del>172</del>	<del>182</del>
	<del>Light gray shale</del>	<del>182</del>	<del>191</del>
	<del>Extra hard rock</del>	<del>191</del>	<del>192</del>
	<del>Tan sand stone</del>	<del>192</del>	<del>198</del>

8 Screen: **40'** screen  
Manufacturer **superior**  
Type **15%** Dia. **5"**  
Slot/gauze **1/16** Length **4"**  
Set between **296** ft. and **336** ft.  
Fittings:  
Gravel pack  Yes  No Size range of material **7/8**

9 Static water level:  
**140** ft. below land surface Date **8-18-75**

10 Pumping level below land surfaces:  
**138** ft. after **2** hrs. pumping **20** g.p.m.  
\_\_\_\_\_ ft. after \_\_\_\_\_ hrs. pumping \_\_\_\_\_ g.p.m.  
Estimated maximum yield **20** g.p.m.

11 Water sample submitted:  
 Yes  No Date \_\_\_\_\_

12 Well head completion:  
 Pitless adapter  Inches above grade

13 Well grouted?  Yes  No  
 Neat cement  Bentonite  \_\_\_\_\_  
Depth: From **3** ft. to **13** ft.

14 Nearest source of possible contamination:  
ft. **None** Direction \_\_\_\_\_ Type \_\_\_\_\_  
Well disinfected upon completion?  Yes  No

15 Pump: **Reda**  Not installed  
Manufacturer's name **reda pump co**  
Model no. **1749p101** HP **1** Volts **220**  
Length of drop pipe \_\_\_\_\_ ft. capacity \_\_\_\_\_ g.p.m.  
Type:  
 Submersible  Turbine  
 Jet  Reciprocating  
 Centrifugal  Other

16 Remarks: elevation  
Topography:  
 Hill  
 Slope  
 Upland  
 Valley  
**TOPO**  
**BROCK 7'**  
**2390**  
**7**  
**2383**

17 Water well contractor's certification:  
This well was drilled under my jurisdiction and this report is true to the best of my knowledge and belief.  
**Hodde Drilling Co.** **302**  
Business name License No.  
Address **Route # 1**  
Signed **Phillip Hodde** Date **8-27-75**  
Authorized representative


USE TYPEWRITER OR BALL POINT PEN-PRESS FIRMLY, PRINT CLEARLY.

Kansas State Dept. Of Health  
(Water Well Contractors)  
Forbes-Bldg. 740  
Topeka, Kansas 66620

1 Location of well: County Ford Township name Spearsville Fraction SWSW-SE Section number 20 Town number T26S Range number R22W

Distance and direction from nearest town or city: 6 S of Spearsville  
Street address of well location if in city:

3 Owner of well: Art Shean  
Address: Spearsville, KS

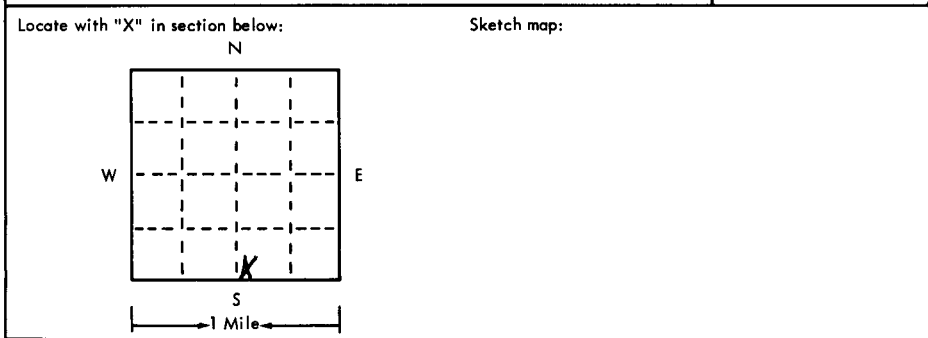

4 Well depth: \_\_\_\_\_ ft. Date of completion \_\_\_\_\_  
Well diameter \_\_\_\_\_ in.

5  Cable tool  Rotary  Driven  Dug  
 Hollow rod  Jetted  Bored  Reverse rotary

6 Use:  Domestic  Public supply  Industry  
 Irrigation  Air conditioning  Commercial  
 Test well

7 Casing: Material \_\_\_\_\_ Height: above/below  
Threaded  Welded  Surface \_\_\_\_\_ in.  
Diam. \_\_\_\_\_ Weight \_\_\_\_\_ lbs./ft. \_\_\_\_\_  
\_\_\_\_\_ in. to \_\_\_\_\_ ft. depth! Drive shoe?  Yes  No  
\_\_\_\_\_ in. to \_\_\_\_\_ ft. depth!

2	Type and color of material	From	To
	<u>Gray shale</u>	<u>198</u>	<u>252</u>
	<u>Little show of sand stone</u>	<u>252</u>	<u>259</u>
	<u>Gray shale</u>	<u>259</u>	<u>270</u>
	<u>Gray shale</u>	<u>270</u>	<u>295</u>
	<u>Light brown sand stone good</u>	<u>295</u>	<u>342</u>
	<u>Gray and brown shale</u>	<u>342</u>	<u>350</u>

8 Screen:  
Manufacturer \_\_\_\_\_  
Type \_\_\_\_\_ Dia. \_\_\_\_\_  
Slot/gauze \_\_\_\_\_ Length \_\_\_\_\_  
Set between \_\_\_\_\_ ft. and \_\_\_\_\_ ft. \_\_\_\_\_  
Fittings:  
Gravel pack  Yes  No Size range of material \_\_\_\_\_

9 Static water level:  
\_\_\_\_\_ ft. below land surface Date \_\_\_\_\_

10 Pumping level below land surfaces:  
\_\_\_\_\_ ft. after \_\_\_\_\_ hrs. pumping \_\_\_\_\_ g.p.m.  
\_\_\_\_\_ ft. after \_\_\_\_\_ hrs. pumping \_\_\_\_\_ g.p.m.  
Estimated maximum yield \_\_\_\_\_ g.p.m.

11 Water sample submitted:  
 Yes  No Date \_\_\_\_\_

12 Well head completion:  
 Pitless adapter  Inches above grade

13 Well grouted?  Yes  No  
 Neat cement  Bentonite  \_\_\_\_\_  
Depth: From \_\_\_\_\_ ft. to \_\_\_\_\_ ft.

14 Nearest source of possible contamination:  
ft. \_\_\_\_\_ Direction \_\_\_\_\_ Type \_\_\_\_\_  
Well disinfected upon completion?  Yes  No

15 Pump:  Not installed  
Manufacturer's name \_\_\_\_\_  
Model number \_\_\_\_\_ HP \_\_\_\_\_ Volts \_\_\_\_\_  
Length of drop pipe \_\_\_\_\_ ft. capacity \_\_\_\_\_ g.m.p.  
Type:  
 Submersible  Turbine  
 Jet  Reciprocating  
 Centrifugal  Other

16 Remarks: elevation

Topography:  
 Hill  
 Slope  
 Upland  
 Valley

(use a second sheet if needed)

17 Water well contractor's certification:  
This well was drilled under my jurisdiction and this report is true to the best of my knowledge and belief.

Hadde Oil Co 302  
Business name License No.  
Address \_\_\_\_\_  
Signed \_\_\_\_\_ Date 9-9-75  
Authorized representative