

USE TYPEWRITER OR BALL POINT PEN—PRESS FIRMLY, PRINT CLEARLY.

BELLEFONT

T R EW sec 1/4 1/4 1/4 No.


WATER WELL RECORD  
KSA 82a-1201-1215

Kansas State Dept. Of Health  
(Water Well Contractors)  
Forbes-Bldg. 740  
Topeka, Kansas 66620

DBB

1 Location of well:	County <b>Ford</b>	Township name <b>Spearville</b>	Fraction <b>NW 1/4 NW 1/4 SE 1/4 20</b>	Section number <b>26</b>	Town number <b>26</b>	Range number <b>22</b>
---------------------	-----------------------	------------------------------------	--	-----------------------------	--------------------------	---------------------------

Distance and direction from nearest town or city: <b>4 1/2 mi South of Spearville</b>	3 Owner of well: <b>Verl Shean (Arthur Shean)</b>
Street address of well location if in city:	Address: <b>Spearville, Kansas</b>

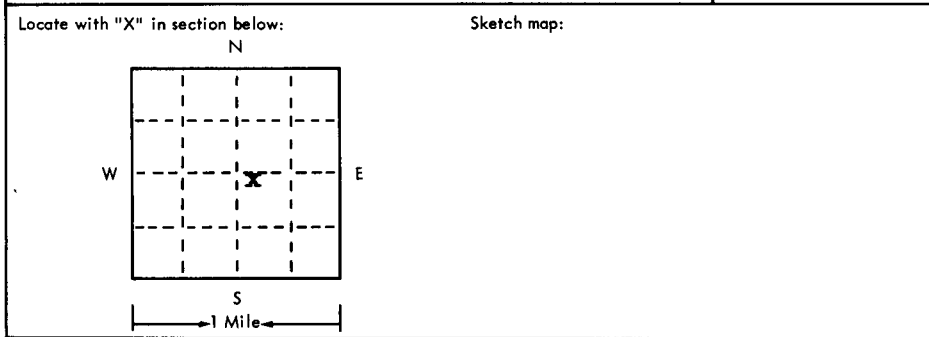

4 Well depth: **355** ft. Date of completion **11-11-74**  
Well diameter **26** in.

5  Cable tool  Rotary  Driven  Dug  
 Hollow rod  Jetted  Bored  Reverse rotary

6 Use:  Domestic  Public supply  Industry  
 Irrigation  Air conditioning  Commercial  
 Test well

7 Casing: Material **Metal** Height: above/below  
Threaded  Welded  Surface **18** in. **AB**  
Diam. **16** Weight \_\_\_\_\_ lbs./ft. \_\_\_\_\_  
\_\_\_\_\_ in. to \_\_\_\_\_ ft. depth Drive shoe?  Yes  No  
\_\_\_\_\_ in. to \_\_\_\_\_ ft. depth

2 Type and color of material	From	To
0-22 Clay	0	12
<del>Cemented gravel</del>	<del>22</del>	<del>27</del>
<del>Clay</del>	<del>27</del>	<del>53</del>
<del>Sandstone</del>	<del>53</del>	<del>58</del>
<del>Shale</del>	<del>58</del>	<del>130</del>
<del>Sandstone</del>	<del>130</del>	<del>142</del>
<del>Shale</del>	<del>142</del>	<del>156</del>
<del>Sandstone</del>	<del>156</del>	<del>167</del>
<del>Shale</del>	<del>167</del>	<del>190</del>
<del>Sandstone with 35% shale mixed</del>	<del>190</del>	<del>196</del>
<del>Shale</del>	<del>196</del>	<del>270</del>
<del>Tan sandstone</del>	<del>270</del>	<del>300</del>
<del>Purple and brown sandstone</del>	<del>300</del>	<del>353</del>
<del>Shale</del>	<del>353</del>	<del>400</del>
<b>BRACK 27'</b>		
<b>CRISTACORNS WELL</b>		

8 Screen: **Free-flo (W.A. Brown)**  
Manufacturer \_\_\_\_\_  
Type **10%** Dia. **16**  
Slot/gauze **1/8 7ka** Length \_\_\_\_\_  
Set between **130** ft. and **170** ft. **190-210**  
Fittings: **270-355**  
Gravel pack  Yes  No Size range of material **down**

9 Static water level:  
**92** ft. below land surface Date **11-12-74**

10 Pumping level below land surfaces:  
**255** ft. after **4** hrs. pumping **1000** g.p.m.  
\_\_\_\_\_ ft. after \_\_\_\_\_ hrs. pumping \_\_\_\_\_ g.p.m.  
Estimated maximum yield **1100** g.p.m.

11 Water sample submitted:  
 Yes  No Date \_\_\_\_\_

12 Well head completion:  
 Pitless adapter  Inches above grade

13 Well grouted?  Yes  No  
 Neat cement  Bentonite  \_\_\_\_\_  
Depth: From \_\_\_\_\_ ft. to \_\_\_\_\_ ft.

14 Nearest source of possible contamination:  
ft. \_\_\_\_\_ Direction **NE** Type \_\_\_\_\_  
Well disinfected upon completion?  Yes  No

15 Pump **set 2-7-75**  Not installed  
Manufacturer's name **Goulds**  
Model number **12JMC** HP **100** Volts **460**  
Length of drop pipe \_\_\_\_\_ ft. capacity \_\_\_\_\_ g.p.m.  
Type:  
 Submersible  Turbine  
 Jet  Reciprocating  
 Centrifugal  Other

16 Remarks: elevation

Topography:  
 Hill  
 Slope  
 Upland **TOPO**  
 Valley

17 Water well contractor's certification:  
This well was drilled under my jurisdiction and this report is true to the best of my knowledge and belief.  
**Ace-Hi Drilling Co. 190A**  
Business name License No. \_\_\_\_\_  
Address **Box 1442, Dodge City, Ks**  
Signed **Carl G. Little** Date **2-19-75**  
Authorized representative

2431  
27  
2404 ✓