


1 LOCATION OF WATER WELL: Fraction NW 1/4 NW 1/4 NW 1/4 Section Number 24 Township Number T 26 S Range Number R 22 EW

Distance and direction from nearest town or city street address of well if located within city?
 1 mile west of the town of Wright

2 WATER WELL OWNER: David Buehne (Buehne Oil Co.)
 RR#, St. Address, Box #: Jct. Hwys. 283 & 56
 City, State, ZIP Code: Wright, Kansas 67882
 Board of Agriculture, Division of Water Resources
 Application Number:

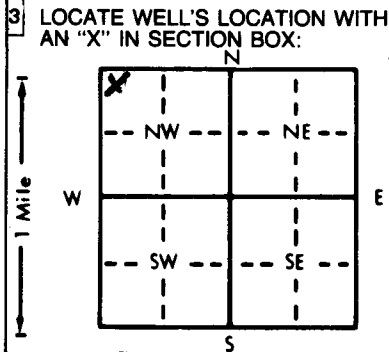

4 DEPTH OF COMPLETED WELL: 135 ft. ELEVATION: ... ft.
 Depth(s) Groundwater Encountered 1. 70 ft. 2. ... ft. 3. ... ft.
 WELL'S STATIC WATER LEVEL 70 ft. below land surface measured on mo/day/yr 4-20-90
 Pump test data: Well water was 75 ft. after 4 hours pumping 20 gpm
 Est. Yield 50 gpm: Well water was ... ft. after ... hours pumping ... gpm
 Bore Hole Diameter 9 in. to 1.35 ft., and ... in. to ... ft.
 WELL WATER TO BE USED AS:
 1 Domestic 3 Feedlot 6 Oil field water supply 9 Dewatering 12 Other (Specify below)
 2 Irrigation 4 Industrial 7 Lawn and garden only 10 Monitoring well
 Was a chemical/bacteriological sample submitted to Department? Yes ... No ... X ...; If yes, mo/day/yr sample was submitted
 Water Well Disinfected? Yes X No

5 TYPE OF BLANK CASING USED:
 1 Steel 3 RMP (SR) 5 Wrought iron 8 Concrete tile CASING JOINTS: Glued X Clamped
 2 PVC 4 ABS 6 Asbestos-Cement 9 Other (specify below) Welded
 7 Fiberglass Threaded
 Blank casing diameter 5 in. to 70 ft., Dia ... in. to ... ft., Dia ... in. to ... ft.
 Casing height above land surface 18 in., weight 250 lbs./ft. Wall thickness or gauge No.
 TYPE OF SCREEN OR PERFORATION MATERIAL:
 1 Steel 3 Stainless steel 5 Fiberglass 7 PVC 10 Asbestos-cement
 2 Brass 4 Galvanized steel 6 Concrete tile 8 RMP (SR) 11 Other (specify)
 9 ABS 12 None used (open hole)
 SCREEN OR PERFORATION OPENINGS ARE:
 1 Continuous slot 3 Mill slot 5 Gauzed wrapped 8 Saw cut 11 None (open hole)
 2 Louvered shutter 4 Key punched 6 Wire wrapped 9 Drilled holes
 7 Torch cut 10 Other (specify)
 SCREEN-PERFORATED INTERVALS: From 70 ft. to 135 ft., From ... ft. to ... ft.
 GRAVEL PACK INTERVALS: From 20 ft. to 135 ft., From ... ft. to ... ft.

6 GROUT MATERIAL: 1 Neat cement 2 Cement grout 3 Bentonite 4 Other
 Grout Intervals: From 3 ft. to 20 ft., From ... ft. to ... ft., From ... ft. to ... ft.
 What is the nearest source of possible contamination:
 1 Septic tank 4 Lateral lines 7 Pit privy 10 Livestock pens 14 Abandoned water well
 2 Sewer lines 5 Cess pool 8 Sewage lagoon 11 Fuel storage 15 Oil well/Gas well
 3 Watertight sewer lines 6 Seepage pit 9 Feedyard 12 Fertilizer storage 16 Other (specify below)
 13 Insecticide storage
 Direction from well? How many feet? 100 ft.

FROM	TO	LITHOLOGIC LOG	FROM	TO	PLUGGING INTERVALS
0	37	topsoil & clay			
37	43	clay			
43	60	clay & rock			
60	75	clay & rock			
75	80	clay			
80	90	soft clay			
90	105	clay & some cemented sand			
105	120	clay & sandy clay			
120	122	clay			
122	128	cemented and & clay			
128	130	clay			
130	132	sandstone			
132	135	clay			

7 CONTRACTOR'S OR LANDOWNER'S CERTIFICATION: This water well was (1) constructed, (2) reconstructed, or (3) plugged under my jurisdiction and was completed on (mo/day/year) 4-31-90 and this record is true to the best of my knowledge and belief. Kansas Water Well Contractor's License No. 130 This Water Well Record was completed on (mo/day/yr) 4-6-90 under the business name of Leo Knoefler Drilling by (signature) Leo Knoefler