

USE TYPEWRITER OR BALL POINT PEN-PRESS FIRMLY, PRINT CLEARLY.

BELLEFONT

T R EW sec 1/4 1/4 1/4 No.

WATER WELL RECORD
KSA 82a-1201-1215


Kansas State Dept. Of Health
(Water Well Contractors)
Forbes-Bldg. 740
Topeka, Kansas 66620

CBA

1 Location of well:	County Ford	Township name Spearville	Fraction NE 1/4 SW	Section number 25	Town number 26 S	Range number 22 W
---------------------	-----------------------	------------------------------------	------------------------------	-----------------------------	----------------------------	-----------------------------

Distance and direction from nearest town or city:
Street address of well location if in city:
10 mile south east of Spearville, Kansas

3 Owner of well: **Leonard Teemont**
Address: **RT. 2 Spearville, Kansas**

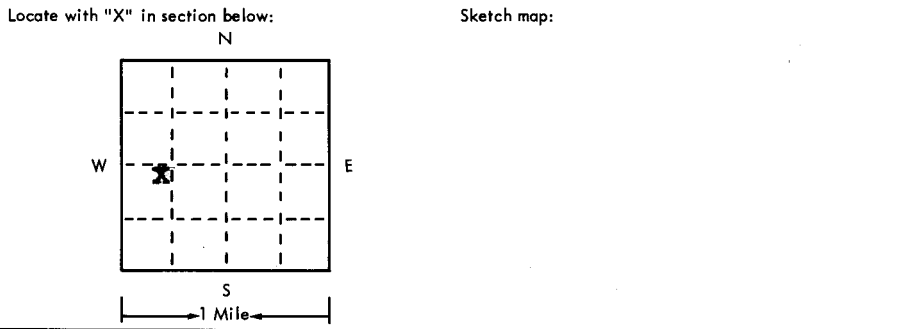

4 Well depth: **355** ft. Date of completion **11-15-75**
Well diameter **5** in.

5 Cable tool Rotary Driven Dug
 Hollow rod Jetted Bored Reverse rotary

6 Use: Domestic Public supply Industry
 Irrigation Air conditioning Commercial
 Test well

7 Casing: Material **plastic** Height: **above** below
Threaded Welded Surface **12** in.
Diam. Weight **1.8** lbs./ft.
5 in. to **355** depth Drive shoe? Yes No

2	Type and color of material	From	To
	Surface	0	3
	Sandy clay	3	8
	Fine sand	8	17
	Light brown clay	17	35
	Fine sand 20% clay	35	41
	Brown clay	41	80
	Little yellow clay	80	82
	82-102 Gray shale	82	102
	Little rock layers	102	103
	Gray shale and layers of red clay	103	130
	Hard rock	130	131
	Gray shale	131	154
	Gray shale with little red bed mixed	154	162
	Brown clay	162	164
	164-177c Gray shale	164	177

8 Screen: **40'** screen
Manufacturer **superior**
Type **15%** Dia. **5"**
Slot gauge **1/16** Length **40'**
Set between **315** ft. and **355** ft.
Fittings:
Gravel pack Yes No Size range of material **3/8**

9 Static water level:
42 ft. below land surface Date **11-15-75**

10 Pumping level below land surfaces:
____ ft. after ____ hrs. pumping ____ g.p.m.
____ ft. after ____ hrs. pumping ____ g.p.m.
Estimated maximum yield ____ g.p.m.

11 Water sample submitted:
 Yes No Date ____

12 Well head completion:
 Pitless adapter Inches above grade

13 Well grouted? Yes No
 Neat cement Bentonite _____
Depth: From **0** ft. to **10** ft.

14 Nearest source of possible contamination:
ft. **200** Direction **east** Type **cow lot**
Well disinfected upon completion? Yes No

15 Pump: Not installed
Manufacturer's name _____
Model number _____ HP _____ Volts _____
Length of drop pipe _____ ft. capacity _____ g.m.p.
Type:
 Submersible Turbine
 Jet Reciprocating
 Centrifugal Other

16 Remarks: elevation
Topography:
 Hill Slope Upland Valley
TRock 80
42
35

17 Water well contractor's certification:
This well was drilled under my jurisdiction and this report is true to the best of my knowledge and belief.
Hodde Drilling Co 302
Business name License No. _____
Address **Rt. 1 Dodge City, Ks**
Signed **Phillip Hodde** Date **11-18-75**
Authorized representative

26
22 W
25
NE NWSW

2952
80
2272v

