


WATER WELL RECORD Form WWC-5 KSA 82A-1212

1 LOCATION OF WATER WELL: COUNTY: 029 FORD FRACTION: NW 1/4 NE 1/4 SE 1/4 SECTION NUMBER: 20 TOWNSHIP NUMBER: T 26 RANGE NUMBER: R 22

DISTANCE AND DIRECTION FROM NEAREST TOWN OR CITY STREET ADDRESS OF WELL IF LOCATED WITHIN CITY?  
FROM SPEARVILLE; APPX 4 1/2 MILES SOUTH

2 WATER WELL OWNER: MICHAEL DEMUTH RR#, St. Address, Box #: 12981 RIDGE ROAD BOARD OF AGRICULTURE, DIVISION OF WATER RESOURCES CITY, STATE, ZIP CODE: FORD, KS 67842-9422 APPLICATION NUMBER: 23208

3 LOCATE WELL'S LOCATION WITH AN "X" IN SECTION BOX:

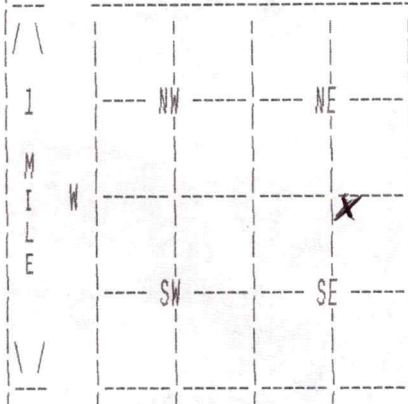

4 DEPTH OF COMPLETED WELL 359 ELEVATION: 0 DEPTH(S) GROUNDWATER ENCOUNTERED 1. 0 FT. 2. 0 FT. 3. 0 FT.

WELL'S STATIC WATER LEVEL 138 FT. BELOW LAND SURFACE MEASURED ON MO/DAY/YR 07/28/00 PUMP TESTDATA: WELL WATER WAS 302 FT. AFTER 4 HOURS PUMPING 1068 GPM

ESTIMATED YIELD 0 GPM; WELL WATER WAS 0 FT. AFTER 0 HOURS PUMPING 0 GPM

BORE HOLE DIAMETER 24 IN. TO 359 FT., AND IN. TO 0 FT.

WELL WATER TO BE USED AS: 02 IRRIGATION

WAS A CHEMICAL/BACTERIOLOGICAL SAMPLE SUBMITTED TO DEPARTMENT? No; If YES, MO/DAY/YR SAMPLE WAS SUBMITTED WATER WELL DISINFECTED? Yes

5 TYPE OF BLANK CASING USED: 01 STEEL CASING JOINTS: WELDED BLANK CASING DIAMETER 16 IN. TO 359 FT., DIA IN. TO 0 FT., DIA IN. TO 0 FT. CASING HEIGHT ABOVE LAND SURFACE 12 IN., WEIGHT 42 LBS/FT. WALL THICKNESS OR GAUGE NO. .250 TYPE OF SCREEN OR PERFORATION MATERIAL: 01 STEEL SCREEN OR PERFORATION OPENINGS ARE: 01 CONT. SLOT

SCREEN PERFORATED INTERVALS: FROM 264 FT. TO 354 FT., FROM 0 FT. TO 0 FT. FROM 0 FT. TO 0 FT. GRAVEL PACK INTERVALS: FROM 20 FT. TO 359 FT., FROM 0 FT. TO 0 FT. FROM 0 FT. TO 0 FT.

6 GROUT MATERIAL 03 BENTONITE GROUT INTERVALS: FROM 0 FT. TO 20 FT., FROM 0 FT. TO 0 FT., FROM 0 FT. TO 0 FT. WHAT IS THE NEAREST SOURCE OF POSSIBLE CONTAMINATION: IRRIGATION WELL DIRECTION FROM WELL? WEST How MANY FEET? 100

FROM	TO	LITHOLOGIC LOG	FROM	TO	PLUGGING INTERVALS
0	1	02 SILT			
1	19	01 CLAY			
19	25	11 GRAVEL 28 ROCK			
25	51	19 SHALE			
51	58	23 SANDSTONE			
58	70	19 SHALE			
70	80	19 SHALE			
80	101	19 SHALE 20 LIMESTONE			
101	121	SHALE 23 SANDSTONE			
121	147	19 SHALE			

7 CONTRACTOR'S OR LANDOWNER'S CERTIFICATION: THIS WATER WELL WAS CONSTRUCTED UNDER MY JURISDICTION AND WAS COMPLETED ON (MO/DAY/YEAR) 07/26/00 AND THIS RECORD IS TRUE TO THE BEST OF MY KNOWLEDGE AND BELIEF. KANSAS WATER WELL CONTRACTOR'S LICENSE NO. 145 THIS WATER WELL RECORD WAS COMPLETED ON (MO/DAY/YR) 08/03/00 UNDER THE BUSINESS NAME OF HENKLE DRILLING & SUPPLY BY (SIGNATURE)

(CONTINUED)

WATER WELL RECORD Form WWC-5 KSA 82A-1212

LOCATION OF WATER WELL: COUNTY: 029 FORD	FRACTION NW 1/4 NE 1/4 SE 1/4	SECTION NUMBER 20	TOWNSHIP NUMBER T 26 S	RANGE NUMBER R 22 W
---	----------------------------------	----------------------	---------------------------	------------------------

2 WATER WELL OWNER: MICHAEL DEMUTH  
RR#, ST. ADDRESS, BOX #: 12981 RIDGE ROAD

BOARD OF AGRICULTURE, DIVISION OF WATER RESOURCES

CITY, STATE, ZIP CODE : FORD, KS 67842-9422

APPLICATION NUMBER: 23208

FROM	TO	LITHOLOGIC LOG
147	163	19 SHALE
163	170	23 SANDSTONE
170	191	19 SHALE
191	195	23 SANDSTONE
195	234	19 SHALE 20 LIMESTONE
234	251	19 SHALE
251	261	19 SHALE
261	270	19 SHALE 23 SANDSTONE
270	292	23 SANDSTONE
292	301	23 SANDSTONE 19 SHALE
301	341	23 SANDSTONE
341	344	23 SANDSTONE
344	354	23 SANDSTONE 20 LIMESTONE

7 CONTRACTOR'S OR LANDOWNER'S CERTIFICATION: THIS WATER WELL WAS CONSTRUCTED UNDER MY JURISDICTION AND WAS COMPLETED ON (MO/DAY/YEAR) 07/26/00 AND THIS RECORD IS TRUE TO THE BEST OF MY KNOWLEDGE AND BELIEF, KANSAS WATER WELL CONTRACTOR'S LICENSE No. 145 THIS WATER WELL RECORD WAS COMPLETED ON (MO/DAY/YR) 08/03/00 UNDER THE BUSINESS NAME OF HENKLE DRILLING & SUPPLY

BY (SIGNATURE)

*Brian J. Reichmuth*